

# SURVEY & REMONUMENTATION

APR 28 1995

## LAND CORNER RECORDATION CERTIFICATE Filing Requirement of Act 74, Mich. P.A. 1970 KENT COUNTY REMONUMENTATION

STATE OF MICHIGAN  
COUNTY OF KENT  
RECEIVED FOR RECORD

94 DEC -6 AM 8:57

*Lucy J. Bond*  
REG. OF DEEDS

For corners in  
Kent **COMMISSION**  
(County)


Located in: Corner Code #

1. Public Land Survey	T <u>6N</u>	R <u>12W</u>	<u>D-2</u>
	T _____	R _____	_____
	T _____	R _____	_____
	T _____	R _____	_____
2. Property Controlling in Section	S _____	T _____	R _____
	S _____	T _____	R _____
3. Miscellaneous Property in Sec.	S _____	T _____	R _____
	S _____	T _____	R _____

7726

Register of Deeds Stamp & File Number

4. Lot No. \_\_\_\_\_, Recorded Plat \_\_\_\_\_  
5. Private Claims \_\_\_\_\_

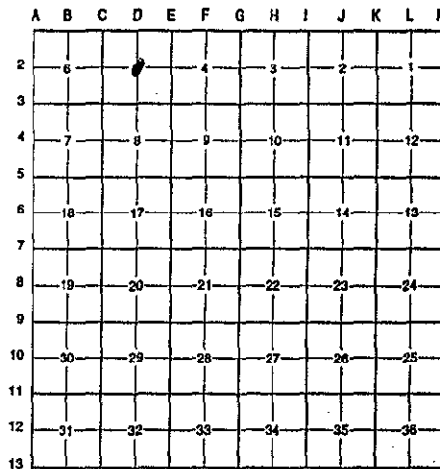

I, Randy Kolehouse, in a field survey on July 12 19 94, do hereby certify that under requirements of P.A. 74 Michigan P.A. of 1970, the corner points mentioned in lines 1 and 2 above were in conformance with regulations and rules therefore as required in the current manual of survey instructions of the United States Department of the Interior, Bureau of Land Management or by a decree of a Court of Law and/or that the corner points mentioned in lines 3, 4 and 5 above were in conformance with the rules of the Michigan Board of Land Surveyors or by a Decree of a Court of Law; established, re-established, monumented, re-monumented, recovered, found as expressed below:

**NOTE:** Not more than 4 corners, all in the same town and range, may be recorded on this certificate.

A. Description of original monument and accessories and/or subsequent restoration:

D-2 This corner was not originally set by the G.L.O.

1938	Survey Records	Williams & Works	Iron
NA	Wit. Map	K.C. Surveyor	Iron
1938-1973	Survey Records	Williams & Works	Iron
1972	L.C.R.C. #344	Williams & Works	1 1/2" Iron
1994	Survey Records	Williams & Works	1" Iron

B. Description of corner evidence found and/or method applied in restoring or reestablishing corner:

B-2 Found 1" iron per Williams & Works survey records 1938-1994 (the location of this corner has been used continually since 1938). Also checks L.C.R.C. #344. 1" iron is 0.3' North and 10' East of the intersection of 1/4 lines. Accepted 1" iron as Center Section.

P.A. 345 1990 KENT COUNTY  
PEER APPROVED 9/22/94  
CHAIRMAN Jerry Hubert

C. Description of monument for corner and accessories established to perpetuate locating the position of the corner:

C-2 Replaced 1" iron with Standard 4" x 30" Kent County Monument.

- Nail in E side 8" Maple East 39.44'
- Nail in SW side 14" Cherry S 10° E 18.50'
- Nail in W side 36" Ash S 40° E 25.52'
- Nail in W side 8" Tw. Elm S 40° W 23.60'
- C/L of ditch South 16.5'



Prepared by Randy J. Kolehouse  
Surveyor's Michigan License No. 25854

Date 12/1/94