

# SURVEY & REMONUMENTATION

Kent County Remonumentation

APR 28 1995

## LAND CORNER RECORDATION CERTIFICATE Filing Requirement of Act 74, Mich. P.A. 1970

STATE OF MICHIGAN  
COUNTY OF KENT  
RECEIVED FOR RECORD  
94 NOV 29 AM 9:18

COMMISSION

For corners in  
Kent


*W. J. Land*  
REG. OF DEEDS

(County)	Located In:	Corner Code #/
1. Public Land Survey	T <u>6N</u> R <u>12W</u>	<u>D-5</u>
	T _____ R _____	_____
	T _____ R _____	_____
	T _____ R _____	_____
2. Property Controlling in Section	S _____ T _____ R _____	_____
	S _____ T _____ R _____	_____
3. Miscellaneous Property in Sec.	S _____ T _____ R _____	_____
	S _____ T _____ R _____	_____

7419

Register of Deeds Stamp & File Number

4. Lot No. \_\_\_\_\_, Recorded Plat \_\_\_\_\_  
5. Private Claims \_\_\_\_\_

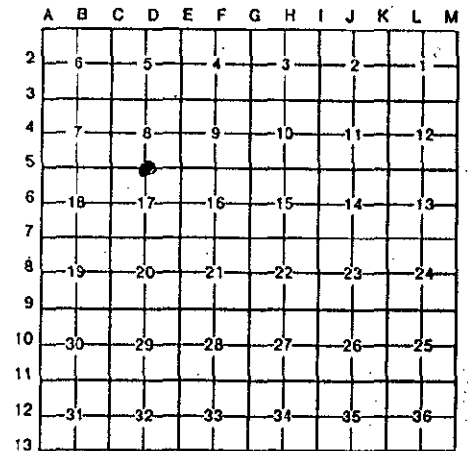

I, Randy Kolehouse, in a field survey on March 31, 19 94, do hereby certify that under requirements of P.A. 74, Michigan P.A. of 1970, the corner points mentioned in lines 1 and 2 above were in conformance with regulations and rules therefore as required in the current manual of survey instructions of the United States Department of the Interior, Bureau of Land Management or by a decree of a Court of Law and/or that the corner points mentioned in lines 3, 4 and 5 above were in conformance with the rules of the Michigan Board of Land Surveyors or by a Decree of a Court of Law; established, re-established, monumented, re-monumented, recovered, found as expressed below:

**NOTE: Not more than 4 corners, all in the same town and range, may be recorded on this certificate.**

**A. Description of original monument and accessories and/or subsequent restoration:**

D-5	1831	G.L.O. Notes	L. Lyon	Set Post
	1927	Wit. Map	K.C. Surveyor	"+" on Pave.
	1973	L.C.R.C. #482	Williams & Works	P.K. Nail
	1981	Survey Notes	Exxel Eng.	P.K. Nail & Tag
	1982	L.C.R.C. #3033	Jonker	Fnd. P.K. Nail & Tag/Set K.C. Mon.

The position of this corner was previously approved by the Kent County Remonumentation Peer Group monumented by Jonker Land Surveys on 7/21/82 and was recorded per L.C.R.C. #3033.

**B. Description of corner evidence found and the method applied in restoring or reestablishing corner:**  
Found K.C. Monument in O.L. of 28th Street turning E-W as set by Rob Jonker in place of a P.K. & Tag he found which checked L.C.R.C. #482 & Exxel Engineering records. This point was set by Williams & Works in 1973 using Williams & Works survey records.

L.C.R.C. #3033


SE cor. CB N 05° E 20.48'  
NW cor. CB S 15° E 19.95'  
Remon. tag on lt. pole S 50° W 62.8'  
On C/L E-W pavement

P.A. 345 1990 KENT COUNTY  
PEER APPROVED 8/11/94  
CHAIRMAN *Randy Thayer*

The selected location is accepted by me and is generally accepted by professional surveyors as the best available evidence of the position of the original corner.

**C. Description of monument for corner and accessories established to perpetuate locating the position of the corner:**

- D-5 Standard Kent County Monument  
SE cor. CB N 05° E 20.70'  
NW cor. CB S 15° E 29.73'  
Nail & K.C. remon. tag NW side lt. pole S 50° W 62.80'  
PK Nail & K.C. remon. tag top guard rail post N 35° W 41.18'  
On C/L E-W pavement

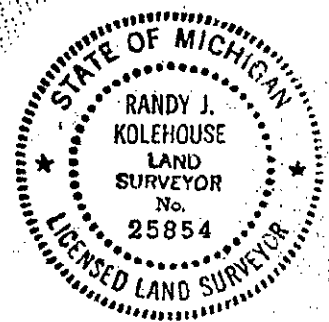

Signed by *Randy J. Kolehouse*

25854

Date

11/21/94

Surveyor's Michigan License No. \_\_\_\_\_