

# SURVEY & REMONUMENTATION

APR 28 1995

## LAND CORNER RECORDATION CERTIFICATE Filing Requirement of Act 74, Mich. P.A. 1970 KENT COUNTY REMONUMENTATION

STATE OF MICHIGAN  
COUNTY OF KENT  
RECEIVED FOR RECORD  
94 DEC -6 AM 8:57

*W. J. Bond*  
REG. OF DEEDS

For corners in Kent **COMMISSION**  
(County)

Located in:	Corner Code #	
1. Public Land Survey	T <u>6N</u> R <u>12W</u>	<u>D-8</u>
	T _____ R _____	_____
	T _____ R _____	_____
	T _____ R _____	_____
2. Property Controlling in Section	S _____ T _____ R _____	_____
	S _____ T _____ R _____	_____
3. Miscellaneous Property in Sec.	S _____ T _____ R _____	_____
	S _____ T _____ R _____	_____

**7730**  
Register of Deeds Stamp & File Number

4. Lot No. \_\_\_\_\_, Recorded Plat \_\_\_\_\_  
5. Private Claims \_\_\_\_\_

	A	B	C	D	E	F	G	H	I	J	K	L	M
2	6	5	4	3	2	1							
3													
4	7	8	9	10	11	12							
5													
6	16	17	18	15	14	13							
7													
8	19	20	21	22	23	24							
9													
10	30	29	28	27	26	25							
11													
12	31	32	33	34	35	36							
13													

I, Randy Kolehouse, in a field survey on November 14, 19 94, do hereby certify that under requirements of P.A. 74 Michigan P.A. of 1970, the corner points mentioned in lines 1 and 2 above were in conformance with regulations and rules therefore as required in the current manual of survey instructions of the United States Department of the Interior, Bureau of Land Management or by a decree of a Court of Law and/or that the corner points mentioned in lines 3, 4 and 5 above were in conformance with the rules of the Michigan Board of Land Surveyors or by a Decree of a Court of Law; established, re-established, monumented, re-monumented, recovered, found as expressed below:

**NOTE:** Not more than 4 corners, all in the same town and range, may be recorded on this certificate.

A. Description of original monument and accessories and/or subsequent restoration:

D-8 This corner was not originally set by the G.L.O.

1944	Survey Records	Williams & Works	Set Iron
1949	Survey Records	Williams & Works	Reset Iron at Intersection 1/4 Lines
1949-1974	Survey Records	Williams & Works	Used Iron Above
1973	L.C.R.C. #511	Exxel Engineering	Set Steel Post
1974	L.C.R.C. #695	Williams & Works	"T" Fence Post

3. Description of corner evidence found and/or method applied in restoring or reestablishing corner:


D-8 "T" fence post as shown in L.C.R.C. #695 and #511 as set by Exxel Engineering using k.C. Wit. Map. Checks the same location as iron set at intersection of 1/4 lines by Williams & Works in 1949. "T" fence post has been destroyed due to gravel excavation. Reset at intersection of 1/4 lines.

P.A. 345 1990 KENT COUNTY  
PEER APPROVED 10/12/94  
CHAIRMAN *Harry [Signature]*

E. Description of monument for corner and accessories established to perpetuate locating the position of the corner:

M-8 Set Standard 4" x 30" Kent County Monument

- Nail & K.C. remon. tag in N side 14" Ash N 80° E 524.97'
- Nail & K.C. remon. tag in W side 10" Ash N 05° E 279.65'
- Nail & K.C. remon. tag in SE side 12" Ash S 82° W 336.86'
- Nail & K.C. remon. tag in E side 12" Maple S 43° W 226.92'

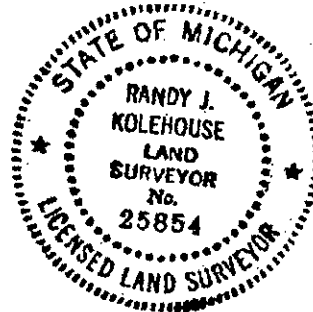

Signed by *Randy J. Kolehouse* Date 12/1/94  
Surveyor's Michigan License No. 25854