

**SURVEY & REMONUMENTATION**

Kent County Remonumentation

STATE OF MICHIGAN  
COUNTY OF KENT  
RECEIVED FOR RECORD

APR 28 1995

**LAND CORNER RECORDATION CERTIFICATE**  
Filing Requirement of Act 74, Mich. P.A. 1970

94 NOV 29 AM 9:18

For corners in  
Kent **COMMISSION**  
(County)

Located In: Corner Code #

*W. J. Bond*  
REG. OF DEEDS

- |                                    |                          |            |
|------------------------------------|--------------------------|------------|
| 1. Public Land Survey              | T <u>6N</u> R <u>12W</u> | <u>D-9</u> |
|                                    | T _____ R _____          | _____      |
|                                    | T _____ R _____          | _____      |
|                                    | T _____ R _____          | _____      |
| 2. Property Controlling in Section | S _____ T _____ R _____  | _____      |
|                                    | S _____ T _____ R _____  | _____      |
| 3. Miscellaneous Property in Sec.  | S _____ T _____ R _____  | _____      |
|                                    | S _____ T _____ R _____  | _____      |

**7420**  
Register of Deeds Stamp & File Number

4. Lot No. \_\_\_\_\_, Recorded Plat \_\_\_\_\_
5. Private Claims \_\_\_\_\_

	A	B	C	D	E	F	G	H	I	J	K	L	M
2	6	5	4	3	2	1							
3													
4	7	8	9	10	11	12							
5													
6	18	17	16	15	14	13							
7													
8	19	20	21	22	23	24							
9													
10	30	29	28	27	26	25							
11													
12	31	32	33	34	35	36							
13													

I, Randy Kolehouse, in a field survey on March 31, 19 94, do hereby certify that under requirements of P.A. 74, Michigan P.A. of 1970, the corner points mentioned in lines 1 and 2 above were in conformance with regulations and rules therefore as required in the current manual of survey instructions of the United States Department of the Interior, Bureau of Land Management or by a decree of a Court of Law and/or that the corner points mentioned in lines 3, 4 and 5 above were in conformance with the rules of the Michigan Board of Land Surveyors or by a Decree of a Court of Law; established, re-established, monumented, re-monumented, recovered, found as expressed below:

**NOTE: Not more than 4 corners, all in the same town and range, may be recorded on this certificate.**

A. Description of original monument and accessories and/or subsequent restoration:

D-9	1831	G.L.O. Notes	L. Lyon	Set Post
	1938	Wit. Map	K.C. Surveyor	Stone
	1974	L.C.R.C. #695	Williams & Works	1-1/2" Iron in Mon. Box
	1974	L.C.R.C. #706	Exxel Engineering	Mon. Box
	1981	L.C.R.C. #1972	Exxel Engineering	Fnd. 1-1/2" Iron in Mon. Box/Set K.C. Mon.

This corner was originally approved by the Kent County Remonumentation Peer Group and monumented by Exxel Engineering, Inc., on 8/31/81 and was recorded per L.C.R.C. #1972.

B. Description of corner evidence found and/or method applied in restoring or reestablishing corner:

D-9 Found K.C. Monument in monument box in C/L of 44th Street running E-W per L.C.R.C. #1972 as set by Exxel Engineering in place of a 1-1/2" iron they found which checks 1938 K.C. Surveyor's wit. map and L.C.R.C.'s #695 & #706.

L.C.R.C. #1972

Nail & K.C. remon. tag in SE side 28" Maple N 43° E 43.15'  
Nail & K.C. remon. tag in E side 26" Maple N 10° W 30.18'  
NW cor. brick porch S 46° W 70.48'  
NE cor. house fndn. S 26° W 54.86'


P.A. 345 1990 KENT COUNTY

PEER APPROVED 7/28/94  
CHAIRMAN *[Signature]*

The selected location is accepted by me and is generally accepted by professional surveyors as the best available evidence of the position of the original corner.

C. Description of monument for corner and accessories established to perpetuate locating the position of the corner:

D-9 Standard Kent County Monument  
Nail & K.C. remon. tag in SE side 28" Maple N 43° E 43.15'  
Nail & K.C. remon. tag in E side 26" Maple N 10° W 30.18'  
NW cor. brick porch S 46° W 70.48'  
NE cor. house fndn. S 26° W 54.86'

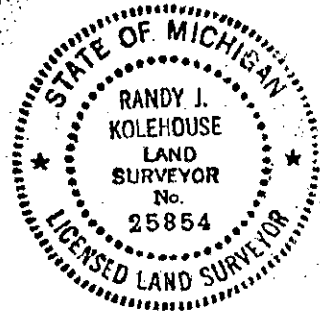

Signed by Randy J. Kolehouse  
Surveyor's Michigan License No. 25854

Date 11/21/94