

# SURVEY & REMONUMENTATION

APR 28 1995

**COMMISSION**

**LAND CORNER RECORDATION CERTIFICATE**  
Filing Requirement of Act 74, Mich. P.A. 1970  
KENT COUNTY REMONUMENTATION

STATE OF MICHIGAN  
COUNTY OF KENT  
RECEIVED FOR RECORD

94 DEC -6 AM 8:57

*Lucy Bond*  
REG. OF DEEDS

For corners in

Kent (County)	Located in:	Corner Code #
1. Public Land Survey	T <u>6N</u> R <u>12W</u>	<u>D-12</u>
	T _____ R _____	_____
	T _____ R _____	_____
	T _____ R _____	_____
2. Property Controlling in Section	S _____ T _____ R _____	_____
	S _____ T _____ R _____	_____
3. Miscellaneous Property in Sec.	S _____ T _____ R _____	_____
	S _____ T _____ R _____	_____

7732

Register of Deeds Stamp & File Number

4. Lot No. \_\_\_\_\_, Recorded Plat \_\_\_\_\_  
5. Private Claims \_\_\_\_\_


I, Randy Kolehouse, in a field survey on June 14 19 94, do hereby certify that under requirements of P.A. 74 Michigan P.A. of 1970, the corner points mentioned in lines 1 and 2 above were in conformance with regulations and rules therefore as required in the current manual of survey instructions of the United States Department of the Interior, Bureau of Land Management or by a decree of a Court of Law and/or that the corner points mentioned in lines 3, 4 and 5 above were in conformance with the rules of the Michigan Board of Land Surveyors or by a Decree of a Court of Law; established, re-established, monumented, re-monumented, recovered, found as expressed below:

**NOTE: Not more than 4 corners, all in the same town and range, may be recorded on this certificate.**

A. Description of original monument and accessories and/or subsequent restoration:

D-12 This corner was not originally set by the G.L.O.

1907-1946	Survey Records	Williams & Works	Long Stone
1946-1972	Survey Records	Williams & Works	Fnd. Iron/Stone/Graded Out
1972	L.C.R.C. #240 & #241	Williams & Works	Iron

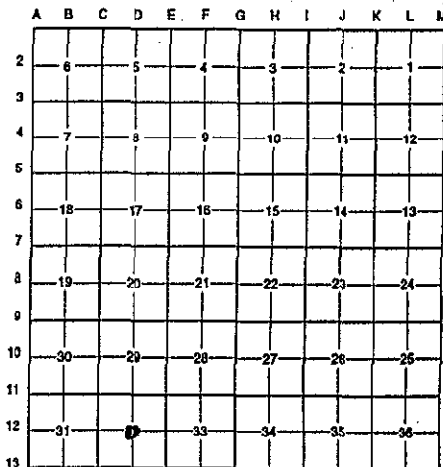

B. Description of corner evidence found and/or method applied in restoring or reestablishing corner:


D-12 Found Nederveld iron 15' ± North of center of road which checks L.C.R.C.'s #240 and #241. Also checks Williams & Works survey records 1907-1972. This point is 13.65' North and 1.6' West of the intersection of 1/4 lines. This corner is currently being used by several area surveyors and its location has been held since 1907. Accepted iron as Center of Section.

P.A. 345 1990 KENT COUNTY  
PEER APPROVED 12/23/94  
CHAIRMAN Jerry Huber

C. Description of monument for corner and accessories established to perpetuate locating the position of the corner:

D-12 Replaced Nederveld iron with Standard 4" x 30" Kent County Monument (Harrison).

- Nail in utl. pole N 05° W 2.70'
- Nail in utl. pole South 74.20'
- NW cor. frame garage S 10° E 131.0'
- SW cor. frame garage N 35° W 114.3'
- C/L road South 15' ±

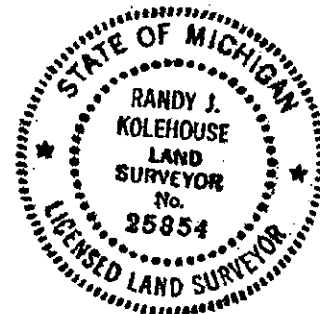

Signed by *Randy J. Kolehouse* Date 12/11/94  
Surveyor's Michigan License No. 25854