

SURVEY & REMONUMENTATION

Kent County Remonumentation

STATE OF MICHIGAN
COUNTY OF KENT
RECEIVED FOR RECORD

APR 28 1995

LAND CORNER RECORDATION CERTIFICATE

94 NOV 29 AM 9:18

COMMISSION

Filing Requirement of Act 74, Mich. P.A. 1970

For corners in
Kent

(County)	Located In:	Corner Code #
1. Public Land Survey	T <u>6N</u> R <u>12W</u>	<u>E-2</u>
	T _____ R _____	_____
	T _____ R _____	_____
	T _____ R _____	_____
2. Property Controlling in Section	S _____ T _____ R _____	_____
	S _____ T _____ R _____	_____
3. Miscellaneous Property in Sec.	S _____ T _____ R _____	_____
	S _____ T _____ R _____	_____

Tracy Bond
REG. OF DEEDS

7424

Register of Deeds Stamp & File Number

4. Lot No. _____, Recorded Plat _____
5. Private Claims _____

	A	B	C	D	E	F	G	H	I	J	K	L	M
2	6	5	4	3	2	1							
3													
4	7	8	9	10	11	12							
5													
6	18	17	16	15	14	13							
7													
8	19	20	21	22	23	24							
9													
10	30	29	28	27	26	25							
11													
12	31	32	33	34	35	36							
13													

I, Randy Kolehouse, in a field survey on March 28, 19 94, do hereby certify that under requirements of P.A. 74, Michigan P.A. of 1970, the corner points mentioned in lines 1 and 2 above were in conformance with regulations and rules therefore as required in the current manual of survey instructions of the United States Department of the Interior, Bureau of Land Management or by a decree of a Court of Law and/or that the corner points mentioned in lines 3, 4 and 5 above were in conformance with the rules of the Michigan Board of Land Surveyors or by a Decree of a Court of Law; established, re-established, monumented, re-monumented, recovered, found as expressed below:

NOTE: Not more than 4 corners, all in the same town and range, may be recorded on this certificate.

A. Description of original monument and accessories and/or subsequent restoration:

E-2	1831	G.L.O. Notes	L. Lyon	Set Post
	1940	Wit. Map	K.C. Surveyor	Iron
	1978	L.C.R.C. #1148	Exxel Engineering	Iron In Mon. Box
	1981	L.C.R.C. #2025	Moore & Bruggink	Fnd. Iron in Mon. Box/Set K.C. Mon.

The position of this corner was previously approved by the Kent County Remonumentation Peer Group monumented by Moore & Bruggink, Inc., on 8/24/81 and was recorded per L.C.R.C. #2025.

B. Description of corner evidence found and/or method applied in restoring or reestablishing corner:

E-2 Found K.C. Monument in Southbound lane of Maynard Avenue running N-S per L.C.R.C. #2025 as set by Moore & Bruggink in place of 1/2" iron in monument box which they found and checked using L.C.R.C. #1148.

L.C.R.C. #2025


- K.C. nail & tag 16" Hackberry S 45° W 34.93'
- K.C. nail & tag 10" Oak W 24.11'
- K.C. nail & tag p. pole S 80° E 45.12'
- K.C. nail & tag 3" Cherry S 30° E 83.50'

P.A. 345 1990 KENT COUNTY
PEER APPROVED *8/11/94*
CHAIRMAN *Harry Kupiec*

The selected location is accepted by me and is generally accepted by professional surveyors as the best available evidence of the position of the original corner.

C. Description of monument for corner and accessories established to perpetuate locating the position of the corner:

- E-2 Standard Kent County Monument
- Nail & K.C. remon. tag 18" Hackberry S 45° W 34.93'
 - Nail & K.C. remon. tag S side 14" Black Oak W 23.98'
 - Nail & K.C. remon. tag S side p. pole S 75° E 45.09'
 - Nail & K.C. remon. tag SW side 6" Cherry S 30° E 83.50'
 - Nail & K.C. remon. tag SE side p. pole S 35° W 70.73'

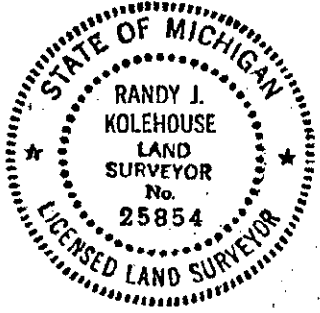

Signed by *Randy J. Kolehouse* Date 11/21/94
Surveyor's Michigan License No. 25854