

SURVEY & REMONUMENTATION

Kent County Remonumentation

STATE OF MICHIGAN
COUNTY OF KENT
RECEIVED FOR RECORD

APR 28 1995

LAND CORNER RECORDATION CERTIFICATE
Filing Requirement of Act 74, Mich. P.A. 1970

94 NOV 29 AM 9:19

COMMISSION

For corners in Kent
(County)

Located In: Corner Code #

Randy J. Kolehouse
REG. OF DEEDS

1. Public Land Survey	T 6N R 12W	E-4
	T _____ R _____	_____
	T _____ R _____	_____
	T _____ R _____	_____
2. Property Controlling in Section	S _____ T _____ R _____	_____
	S _____ T _____ R _____	_____
3. Miscellaneous Property in Sec.	S _____ T _____ R _____	_____
	S _____ T _____ R _____	_____

7426

Register of Deeds Stamp & File Number

- 4. Lot No. _____, Recorded Plat _____
- 5. Private Claims _____

	A	B	C	D	E	F	G	H	I	J	K	L	M
2	6	5	4	3	2	1							
3													
4	7	8	9	10	11	12							
5													
6	18	17	16	15	14	13							
7													
8	19	20	21	22	23	24							
9													
10	30	29	28	27	26	25							
11													
12	31	32	33	34	35	36							
13													

I, Randy Kolehouse, in a field survey on April 22, 19 94, do hereby certify that under requirements of P.A. 74, Michigan P.A. of 1970, the corner points mentioned in lines 1 and 2 above were in conformance with regulations and rules therefore as required in the current manual of survey instructions of the United States Department of the Interior, Bureau of Land Management or by a decree of a Court of Law and/or that the corner points mentioned in lines 3, 4 and 5 above were in conformance with the rules of the Michigan Board of Land Surveyors or by a Decree of a Court of Law; established, re-established, monumented, re-monumented, recovered, found as expressed below:

NOTE: Not more than 4 corners, all in the same town and range, may be recorded on this certificate.

A. Description of original monument and accessories and/or subsequent restoration:

E-4	1831	G.L.O. Notes	L. Lyon	Set Post	P.A. 345 1990 KENT COUNTY
	N/A	Wit. Map	K.C. Surveyor	Conc. Mon.	PEER APPROVED 9/22/94
	1973	L.C.R.C. #597	Exxel Engineering	1/2" Iron in Conc.	CHAIRMAN <i>Randy Kolehouse</i>
	1976	L.C.R.C. #927	Williams & Works	Conc. Monument	
	1982	L.C.R.C. #2703	Jonker	1/2" Iron in 24"x24" Conc.	

The position of this corner was previously approved by the Kent County Remonumentation Peer Group monumented by Williams & Works on 5/19/76 and was recorded per L.C.R.C. #927 and also recorded 3/11/82 per L.C.R.C. #2703.

B. Description of corner evidence found and/or method applied in restoring or reestablishing corner:

E-4 Found 1/2" Iron in concrete slab per L.C.R.C. #2703 which also checks L.C.R.C.'s #597, #927 and K.C. Survey wit. map. No K.C. Monument has been set at this point.

L.C.R.C. #927

L.C.R.C. #2703


PK nail in E side 30" Oak N 164.75'
Const. spike & bottle cap in E side of 26" Walnut N 75° E 7.28'
SE cor. conc. base to lt. pole S 45° W 67.50'
NE cor. conc. drive N 80° W 37.8'

Remon. tag on NW side 30" Walnut N 75° E 7.28'

The selected location is accepted by me and is generally accepted by professional surveyors as the best available evidence of the position of the original corner.

C. Description of monument for corner and accessories established to perpetuate locating the position of the corner:

E-4 1/2" Iron In 24"x24" Concrete Slab
PK nail in E side 30" Oak N 164.75'
Const. spike & bottle cap in E side of 26" Walnut N 75° E 7.28'
SE cor. conc. base to lt. pole S 45° W 67.50'
NE cor. conc. drive N 80° W 37.8'
Nail & K.C. remon. tag on NW side 30" Walnut N 75° E 7.28'

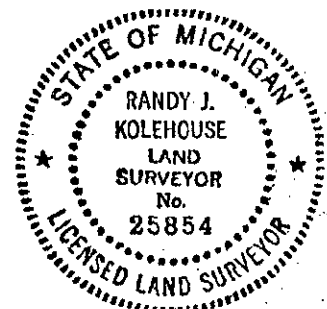

Signed by *Randy J. Kolehouse*
Surveyor's Michigan License No. 25854

Date 11/21/94