

SURVEY & REMONUMENTATION

APR 28 1995

Kent County Remonumentation

STATE OF MICHIGAN
COUNTY OF KENT
RECEIVED FOR RECORD

COMMISSION

LAND CORNER RECORDATION CERTIFICATE
Filing Requirement of Act 74, Mich. P.A. 1970

94 NOV 29 AM 9:19

For corners in
Kent

Located In:

Corner Code ==

1. Public Land Survey	T <u>6N</u> R <u>12W</u>	<u>E-6</u>
	T _____ R _____	_____
	T _____ R _____	_____
	T _____ R _____	_____
2. Property Controlling in Section	S _____ T _____ R _____	_____
	S _____ T _____ R _____	_____
3. Miscellaneous Property in Sec.	S _____ T _____ R _____	_____
	S _____ T _____ R _____	_____

Tim J. Bond
REG. OF DEEDS

7428

Register of Deeds Stamp & File Number

4. Lot No. _____, Recorded Plat _____
5. Private Claims _____

	A	B	C	D	E	F	G	H	I	J	K	L	M
2	6	5	4	3	2	1							
3													
4	7	8	9	10	11	12							
5													
6	18	17	16	15	14	13							
7													
8	19	20	21	22	23	24							
9													
10	30	29	28	27	26	25							
11													
12	31	32	33	34	35	36							
13													

I, Randy Kolehouse, in a field survey on March 31, 19 94, do hereby certify that under requirements of P.A. 74, Michigan P.A. of 1970, the corner points mentioned in lines 1 and 2 above were in conformance with regulations and rules therefore as required in the current manual of survey instructions of the United States Department of the Interior, Bureau of Land Management or by a decree of a Court of Law and/or that the corner points mentioned in lines 3, 4 and 5 above were in conformance with the rules of the Michigan Board of Land Surveyors or by a Decree of a Court of Law; established, re-established, monumented, re-monumented, recovered, found as expressed below:

NOTE: Not more than 4 corners, all in the same town and range, may be recorded on this certificate.

A. Description of original monument and accessories and/or subsequent restoration:

E-6	1831	G.L.O. Notes	L. Lyon	Set Post
	1956	Wit. Map	K.C. Surveyor	1" Iron
	1972	L.C.R.C. #178	Williams & Works	R.R. Spike
	1982	L.C.R.C. #2820	Jonker	Fnd. R.R. Spike/Set K.C. Mon.

This corner was originally approved by the Kent County Remonumentation Peer Group and monumented by Jonker Land Surveys on 4/28/82 and was recorded per L.C.R.C. #2820.

B. Description of corner evidence found and/or method applied in restoring or reestablishing corner:

E-6 Found K.C. Monument at approximate C/L "X" of Ivanrest venue running N-S and Prairie Street running E-W per L.C.R.C. #2820 which was set in place of a R.R. spike which he found and checked with L.C.R.C. #178.

L.C.R.C. #2820


- Nail & K.C. remon. tag on NE side p. pole S 60° E 56.56'
- Nail & K.C. remon. tag on SE side t. pole S 65° W 60.00"
- SE cor. brick on house N 40° W 118.28'
- C/L M.H. S 15° E 7.02'
- C/L M.H. N 80° W 6.31'

P.A. 345 1990 KENT COUNTY
PEER APPROVED 8/11/94
CHAIRMAN Harry Hubers

The selected location is accepted by me and is generally accepted by professional surveyors as the best available evidence of the position of the original corner.

C. Description of monument for corner and accessories established to perpetuate locating the position of the corner:

- E-6 Standard Kent County Monument
- Nail & K.C. remon. tag on NE side p. pole S 60° E 56.56'
- Nail & K.C. remon. tag on SE side t. pole S 65° W 60.00"
- SE cor. brick on house N 40° W 118.28'
- C/L M.H. S 15° E 7.02'
- C/L M.H. N 80° W 6.31'

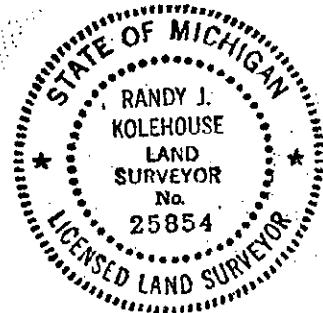

Signed by Randy J. Kolehouse
Surveyor's Michigan License No. 25854

Date 11/21/94