

SURVEY & REMONUMENTATION

APR 28 1995

COMMISSION

Kent County Remonumentation

LAND CORNER RECORDATION CERTIFICATE
Filing Requirement of Act 74, Mich. P.A. 1970

STATE OF MICHIGAN
COUNTY OF KENT
RECEIVED FOR RECORD

94 NOV 29 AM 9:19

Tim J. Bond
REG. OF DEEDS

For corners in
Kent

(County)	Located In:	Corner Code #
1. Public Land Survey	T 6N R 12W	E-8
	T _____ R _____	_____
	T _____ R _____	_____
	T _____ R _____	_____
2. Property Controlling in Section	S _____ T _____ R _____	_____
	S _____ T _____ R _____	_____
3. Miscellaneous Property in Sec.	S _____ T _____ R _____	_____
	S _____ T _____ R _____	_____

7430

Register of Deeds Stamp & File Number

4. Lot No. _____, Recorded Plat _____
5. Private Claims _____

I, Randy Kolehouse, in a field survey on March 24, 1994

do hereby certify that under requirements of P.A. 74, Michigan P.A. of 1970, the corner points mentioned in lines 1 and 2 above were in conformance with regulations and rules therefore as required in the current manual of survey instructions of the United States Department of the Interior, Bureau of Land Management or by a decree of a Court of Law and/or that the corner points mentioned in lines 3, 4 and 5 above were in conformance with the rules of the Michigan Board of Land Surveyors or by a Decree of a Court of Law; established, re-established, monumented, re-monumented, recovered, found as expressed below:

NOTE: Not more than 4 corners, all in the same town and range, may be recorded on this certificate.

	A	B	C	D	E	F	G	H	I	J	K	L	M
2	6	5	4	3	2	1							
3													
4	7	8	9	10	11	12							
5													
6	18	17	16	15	14	13							
7													
8	19	20	21	22	23	24							
9													
10	30	29	28	27	26	25							
11													
12	31	32	33	34	35	36							
13													

A. Description of original monument and accessories and/or subsequent restoration:

E-8	1831	G.L.O. Notes	L. Lyon	Set Post
	N/A	Wit. Map	K.C. Surveyor	Iron
	1971	L.C.R.C. #58	Williams & Works	Iron
	1972	L.C.R.C. #279	Medema Van Kooten	Iron
	1982	L.C.R.C. #2819	Jonker	Fnd. 1/2" Iron/Set K.C. Mon.

P.A. 345 1990 KENT COUNTY

PEER APPROVED 9/22/99
CHAIRMAN Harry Huber

The position of this corner was previously approved by the Kent County Remonumentation Peer Group monumented by Jonker Land Surveys on 3/22/82 and was recorded per L.C.R.C. #2819.

B. Description of corner evidence found and/or method applied in restoring or reestablishing corner:

E-8 Found K.C. Monument in C/L of Ivanrest Avenue running N-S on C/L of 40th Street running W per L.C.R.C. #2819 as set by Rob Jonker in place of a 1/2" iron over a 1/2" iron he found checks L.C.R.C.'s #58 and #279. Also checks K.C. Surveyor's wit. map.


L.C.R.C. #2819

SW cor. brick to garage N 80° E 89.60'
NW cor. hse. fnd. S 70° E 95.8'
NE cor. hse. fnd. S 45° W 134.23'
SW cor. hse. fnd. S 55° E 110.27'

The selected location is accepted by me and is generally accepted by professional surveyors as the best available evidence of the position of the original corner.

C. Description of monument for corner and accessories established to perpetuate locating the position of the corner:

E-8 Standard Kent County Monument
SW cor. brick to garage N 80° E 89.60'
NW cor. hse. fnd. S 70° E 95.8'
NE cor. hse. fnd. S 45° W 134.23'
SW cor. hse. fnd. S 55° E 110.27'

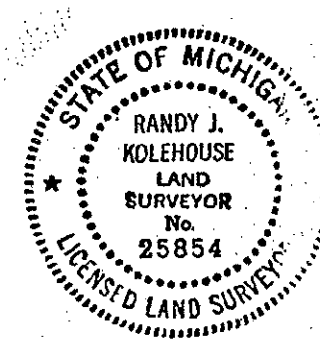

Signed by Randy J. Kolehouse
Surveyor's Michigan License No. 25854

Date 11/21/94