

SURVEY & REMONUMENTATION

Kent County Remonumentation

STATE OF MICHIGAN
COUNTY OF KENT
RECEIVED FOR RECORD

APR 28 1995

LAND CORNER RECORDATION CERTIFICATE 94 NOV 29 AM 9:19
Filing Requirement of Act 74, Mich. P.A. 1970

For corners in **COMMISSION**
Kent
(County)

Located In:	Corner Code #
1. Public Land Survey T <u>6N</u> R <u>12W</u>	<u>E-11</u>
T _____ R _____	_____
T _____ R _____	_____
T _____ R _____	_____
2. Property Controlling S _____ T _____ R _____	_____
in Section S _____ T _____ R _____	_____
3. Miscellaneous S _____ T _____ R _____	_____
Property in Sec. S _____ T _____ R _____	_____

W. J. Bond
REG. OF DEEDS

7433
Register of Deeds Stamp & File Number

4. Lot No. _____, Recorded Plat _____
5. Private Claims _____

	A	B	C	D	E	F	G	H	I	J	K	L	M
2	6	5	4	3	2	1							
3													
4	7	8	9	10	11	12							
5													
6	18	17	16	15	14	13							
7													
8	19	20	21	22	23	24							
9													
10	30	29	28	27	26	25							
11													
12	31	32	33	34	35	36							
13													

I, Randy Kolehouse, in a field survey on March 24, 1994, do hereby certify that under requirements of P.A. 74, Michigan P.A. of 1970, the corner points mentioned in lines 1 and 2 above were in conformance with regulations and rules theretofore as required in the current manual of survey instructions of the United States Department of the Interior, Bureau of Land Management or by a decree of a Court of Law and/or that the corner points mentioned in lines 3, 4 and 5 above were in conformance with the rules of the Michigan Board of Land Surveyors or by a Decree of a Court of Law; established, re-established, monumented, re-monumented, recovered, found as expressed below:

NOTE: Not more than 4 corners, all in the same town and range, may be recorded on this certificate.

A. Description of original monument and accessories and/or subsequent restoration:

E-11	1831	G.L.O. Notes	L. Lyon	Set Post
	1953	K.C.R.C.	Witness Map	Iron
	1972	L.C.R.C. #364	Exxel Eng.	Iron in Mon. Box
	1973	L.C.R.C. #439	Medema, Van Kooten	Iron in Mon. Box
	1981	L.C.R.C. #1833	Exxel Eng.	Iron in Mon. Box/Set K.C. Mon.

P.A. 345 1990 KENT COUNTY
PEER APPROVED 7/28/94
CHAIRMAN Harry Kasper

The position of this corner was previously approved by the Kent County Remonumentation Peer Group and monumented by Exxel Engineering, Inc., on 6/2/81 and was recorded per L.C.R.C. #1833.

B. Description of corner evidence found and/or method applied in restoring or reestablishing corner:

E-11 Found K.C. Monument in C/L of Ivanrest Avenue running N-S on C/L 52nd Street running E-W per L.C.R.C. #1833 as set by Exxel Engineering in place of iron in monument box which they found and checked by K.C. Surveyor's wit. map & L.C.R.C.'s #364 and #439.


L.C.R.C. #1833

Nail & K.C. remon. tag in N side double 18" Cherry S 70° E 107.41'
Nail in W side 36" Maple S 10° E 167.82'

The selected location is accepted by me and is generally accepted by professional surveyors as the best available evidence of the position of the original corner.

C. Description of monument for corner and accessories established to perpetuate locating the position of the corner:

- E-11 Standard Kent County Monument
- Nail & K.C. remon. tag 18" Cherry S 70° E 107.42'
 - Nail & K.C. remon. tag N side tri. 8" tree S 70° E 103.18'
 - Nail & K.C. remon. tag NW side p. pole S 35° W 61.42'
 - Nail & K.C. remon. tag NE side p. pole N 45° W 64.90'
 - Nail & K.C. remon. tag W side 6" Elm S 64° W 71.57'
 - Nail in W side 36" Maple S 10° E 167.28'

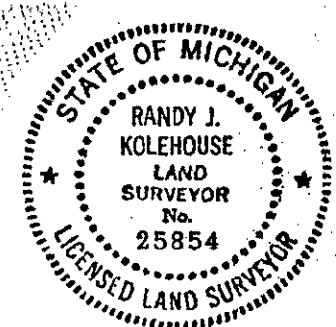

Signed by Randy J. Kolehouse
Surveyor's Michigan License No. 25854

Date 11/21/94