

APR 28 1995

LAND CORNER RECORDATION CERTIFICATE
Filing Requirement of Act 74, Mich. P.A. 1970

NOV 29 AM 9:19

COMMISSION

For corners in
Kent

	Located In:	Corner Code #
1. Public Land Survey	T <u>6N</u> R <u>12W</u>	<u>F-1</u>
	T _____ R _____	_____
	T _____ R _____	_____
	T _____ R _____	_____
2. Property Controlling in Section	S _____ T _____ R _____	_____
	S _____ T _____ R _____	_____
3. Miscellaneous Property in Sec.	S _____ T _____ R _____	_____
	S _____ T _____ R _____	_____

W. J. Bond
REG. OF DEEDS

7436

Register of Deeds Stamp & File Number

4. Lot No. _____, Recorded Plat _____
5. Private Claims _____

	A	B	C	D	E	F	G	H	I	J	K	L	M
2	6	5	4	3	2	1							
3													
4	7	8	9	10	11	12							
5													
6	18	17	16	15	14	13							
7													
8	19	20	21	22	23	24							
9													
10	30	29	28	27	26	25							
11													
12	31	32	33	34	35	36							
13													

I, Randy Kolehouse, in a field survey on August 31, 19 94, do hereby certify that under requirements of P.A. 74, Michigan P.A. of 1970, the corner points mentioned in lines 1 and 2 above were in conformance with regulations and rules therefore as required in the current manual of survey instructions of the United States Department of the Interior, Bureau of Land Management or by a decree of a Court of Law and/or that the corner points mentioned in lines 3, 4 and 5 above were in conformance with the rules of the Michigan Board of Land Surveyors or by a Decree of a Court of Law; established, re-established, monumented, re-monumented, recovered, found as expressed below:

NOTE: Not more than 4 corners, all in the same town and range, may be recorded on this certificate.

A. Description of original monument and accessories and/or subsequent restoration:

F-1	This corner was not originally set by the G.L.O.			
1939	Survey Records	E. H. Christ	Iron	
1978	L.C.R.C. #1148	Exxel Engineering	Iron	
1985	L.C.R.C. #4122	William Byl	Fnd. Iron/Set K.C. Monument	
1990	L.C.R.C. #5565	Thomas Starr	K.C. Monument	

P.A. 345 1990 KENT COUNTY
PEER APPROVED 9/22/94
CHAIRMAN *Randy Kolehouse*

The position of this corner was previously approved by the Kent County Remonumentation Peer Group monumented by William R. Byl on 1/8/85 and was recorded per L.C.R.C. #4122.

B. Description of corner evidence found and/or method applied in restoring or reestablishing corner:

F-1 Found K.C. Monument per L.C.R.C. #4122 as set by William Byl in place of a 1" Iron he found that checked L.C.R.C. #1148 and survey recrods of E.H. Christ (1939).

L.C.R.C. #4122


L.C.R.C. #5565

Nail & K.C. remon. tag in 15" Willow N 10° E 6.17' Nail & K.C. remon. tag in W side 16" Willow N 10° E 6.14'
Nail & K.C. remon. tag in NW side 10" Ash S 40° W 4.17' Nail & K.C. remon. tag in NW side 10" Ash S 40° W 4.17'
30' ± West to edge of water

The selected location is accepted by me and is generally accepted by professional surveyors as the best available evidence of the position of the original corner.

C. Description of monument for corner and accessories established to perpetuate locating the position of the corner:

F-1 Standard Kent County Monument
Nail & K.C. remon. tag in W side 16" Willow N 10° E 6.14'
Nail & K.C. remon. tag in NW side 10" Ash S 40° W 4.17'
Nail & K.C. remon. tag in E side Dbl. 6" Silver Maple N 35° E 49.55'
Nail & K.C. remon. tag in N side 15" Cottonwood N 35° W 107.82'
30' ± West to edge of water

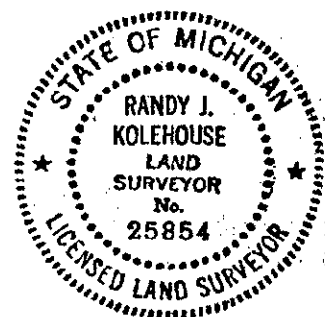

Signed by *Randy J. Kolehouse*
Surveyor's Michigan License No. 25854

Date 11/21/94