

**SURVEY & REMONUMENTATION**

APR 28 1995

**LAND CORNER RECORDATION CERTIFICATE**  
 Filing Requirement of Act 74, Mich. P.A. 1970  
 KENT COUNTY REMONUMENTATION

STATE OF MICHIGAN  
 COUNTY OF KENT  
 RECEIVED FOR RECORD

94 DEC -6 AM 8:57

For corners in **COMMISSION**

*W. J. Bond*  
 REG. OF DEEDS

For corners in	Located in:	Corner Code #
<u>Kent</u> (County)		
1. Public Land Survey	T <u>6N</u> R <u>12W</u>	<u>E-2</u>
	T _____ R _____	_____
	T _____ R _____	_____
	T _____ R _____	_____
2. Property Controlling in Section	S _____ T _____ R _____	_____
	S _____ T _____ R _____	_____
3. Miscellaneous Property in Sec.	S _____ T _____ R _____	_____
	S _____ T _____ R _____	_____

**7733**  
 Register of Deeds Stamp & File Number

- 4. Lot No. \_\_\_\_\_, Recorded Plat \_\_\_\_\_
- 5. Private Claims \_\_\_\_\_

	A	B	C	D	E	F	G	H	I	J	K	L	M
2	6	5	4	3	2	1							
3													
4	7	8	9	10	11	12							
5													
6	16	17	18	15	14	13							
7													
8	19	20	21	22	23	24							
9													
10	30	29	28	27	26	25							
11													
12	31	32	33	34	35	36							
13													

I, Randy Kolehouse, in a field survey on November 3 19 94, do hereby certify that under requirements of P.A. 74 Michigan P.A. of 1970, the corner points mentioned in lines 1 and 2 above were in conformance with regulations and rules therefore as required in the current manual of survey instructions of the United States Department of the interior, Bureau of Land Management or by a decree of a Court of Law and/or that the corner points mentioned in lines 3, 4 and 5 above were in conformance with the rules of the Michigan Board of Land Surveyors or by a Decree of a Court of Law; established, re-established, monumented, re-monumented, recovered, found as expressed below:


**NOTE: Not more than 4 corners, all in the same town and range, may be recorded on this certificate.**

A. Description of original monument and accessories and/or subsequent restoration:  
 F-2 This corner was not originally set by the G.L.O.  
 1939 Survey Records E.H. Christ Set Iron

B. Description of corner evidence found and/or method applied in restoring or reestablishing corner:  
 F-2 Found 1" iron pipe as set by E.H. Christ in 1939. This iron was apparently set 2668' South of the N 1/4 corner on a mean bearing between E & W line of Section as the South 1/4 and East 1/4 corners of the Section are South of the Grand River. This iron is approximately 79' North of a line. This location is about the same as shown in Williams & Works surveys 1939-1940 although no iron was set by Williams & Works. Accepted iron as Center of Section.

P.A. 345 1990 KENT COUNTY  
 PEER APPROVED 11/17/94  
 CHAIRMAN *Harry Huber*

C. Description of monument for corner and accessories established to perpetuate locating the position of the corner:  
 F-2 Replaced iron with a Standard 4" x 30" Kent County Monument.  
 Nail & K.C. remon. tag in the SW side 16" Ash N 50° W 39.61'  
 Nail & K.C. remon. tag in the NW side 6" Maple N 55° E 44.32'  
 Nail & K.C. remon. tag in the N side 8" Maple S 65° E 16.24'  
 Nail & K.C. remon. tag in the NE side 15" Ash S 30° E 21.31'  
 Nail & K.C. remon. tag in the NW side 10" Ash S 25° W 5.62'

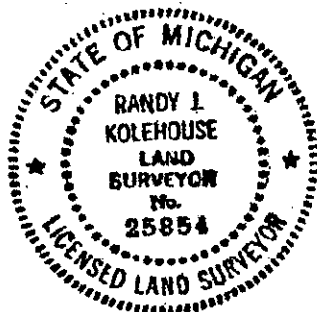

Measure North to N 1/4 corner 2668.9' (E.H. Christ 1939 = 2668.5)

Signed by Randy J. Kolehouse Date 12/1/94  
 Surveyor's Michigan License No. 25854