

SURVEY & REMONUMENTATION

Kent County Remonumentation

STATE OF MICHIGAN
COUNTY OF KENT
RECEIVED FOR RECORD

APR 28 1995

LAND CORNER RECORDATION CERTIFICATE 94 NOV 29 AM 9:19
Filing Requirement of Act 74, Mich. P.A. 1970

COMMISSION

For corners in Kent


For corners in Kent	Located In:	Corner Code #
(County)		
1. Public Land Survey	T <u>6N</u> R <u>12W</u>	<u>F-3</u>
	T _____ R _____	_____
	T _____ R _____	_____
	T _____ R _____	_____
2. Property Controlling in Section	S _____ T _____ R _____	_____
	S _____ T _____ R _____	_____
3. Miscellaneous Property in Sec.	S _____ T _____ R _____	_____
	S _____ T _____ R _____	_____

Lee J. Bond
REG. OF DEEDS

7437

Register of Deeds Stamp & File Number

- 4. Lot No. _____, Recorded Plat _____
- 5. Private Claims _____

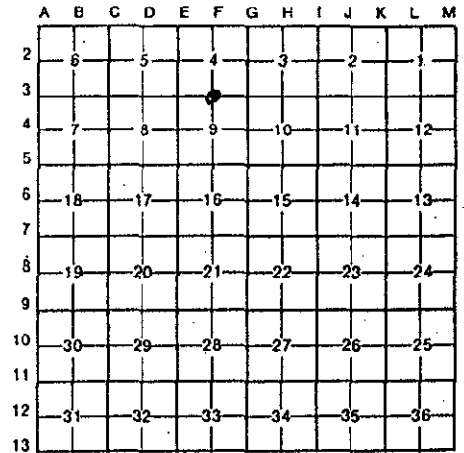

I, Randy Kolehouse, in a field survey on April 22, 19 94, do hereby certify that under requirements of P.A. 74, Michigan P.A. of 1970, the corner points mentioned in lines 1 and 2 above were in conformance with regulations and rules therefore as required in the current manual of survey instructions of the United States Department of the Interior, Bureau of Land Management or by a decree of a Court of Law and/or that the corner points mentioned in lines 3, 4 and 5 above were in conformance with the rules of the Michigan Board of Land Surveyors or by a Decree of a Court of Law; established, re-established, monumented, re-monumented, recovered, found as expressed below:

NOTE: Not more than 4 corners, all in the same town and range, may be recorded on this certificate.

A. Description of original monument and accessories and/or subsequent restoration:

F-3	1831	G.L.O. Notes	L. Lyon	Set Post
	N/A	Wit. Map	K.C. Surveyor	Iron & Stone
	1985	L.C.R.C. #4350	Exxel Engineering	Fnd. Iron/Set K.C. Mon.

The position of this corner was previously approved by the Kent County Remonumentation Peer Group monumented by Exxel Engineering on 11/12/85 and was recorded per L.C.R.C. #4350.

B. Description of corner evidence found and/or method applied in restoring or reestablishing corner:

F-3 Found K.C. Monument per L.C.R.C. #4350 as set by Exxel Engineering in place of a bent iron which they found and checked using 1960 Williams & Works survey records.
L.C.R.C. #4350


- Nail & remon. tag in N side 18" Elm S 85° W 91.27'
- Nail & remon. tag in E side 12" Cottonwood S 7° W 71.53'
- Nail & remon. tag in E side 8" Cottonwood S 42° E 23.36'
- Nail & remon. tag in S side 12" Cottonwood N 60° E 59.44'
- Nail & remon. tag in SW side 10" Elm N 51° W 70.26'

P.A. 345 1990 KENT COUNTY
PEER APPROVED 9/22/94
CHAIRMAN *Stan Huber*

The selected location is accepted by me and is generally accepted by professional surveyors as the best available evidence of the position of the original corner.

C. Description of monument for corner and accessories established to perpetuate locating the position of the corner:

- F-3 Standard Kent County Monument
- Nail & K.C. remon. tag in N side 18" Elm S 85° W 91.27'
 - Nail & K.C. remon. tag in E side 12" Cottonwood S 7° W 71.53'
 - Nail & K.C. remon. tag in E side 8" Cottonwood S 42° E 23.36'
 - Nail & K.C. remon. tag in S side 12" Cottonwood N 60° E 59.44'
 - Nail & K.C. remon. tag in SW side 10" Elm N 51° W 70.26'

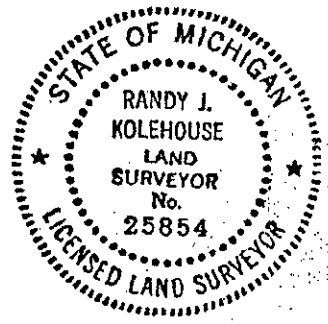

Signed by *Randy Kolehouse*
Surveyor's Michigan License No. 25854

Date 11/21/94