

**SURVEY & REMONUMENTATION**

Kent County Remonumentation

STATE OF MICHIGAN  
COUNTY OF KENT  
RECEIVED FOR RECORD

APR 28 1995

LAND CORNER RECORDATION CERTIFICATE 94 NOV 29 AM 9:19  
Filing Requirement of Act 74, Mich. P.A. 1970

For corners of **COMMISSION**  
Kent

*Tim J. Jones*  
REG. OF DEEDS

| (County)                           | Located In:              | Corner Code # |
|------------------------------------|--------------------------|---------------|
| 1. Public Land Survey              | T <u>6N</u> R <u>12W</u> | <u>F-5</u>    |
|                                    | T _____ R _____          | _____         |
|                                    | T _____ R _____          | _____         |
|                                    | T _____ R _____          | _____         |
| 2. Property Controlling in Section | S _____ T _____ R _____  | _____         |
|                                    | S _____ T _____ R _____  | _____         |
| 3. Miscellaneous Property in Sec.  | S _____ T _____ R _____  | _____         |
|                                    | S _____ T _____ R _____  | _____         |

**7438**  
Register of Deeds Stamp & File Number

4. Lot No. \_\_\_\_\_, Recorded Plat \_\_\_\_\_  
5. Private Claims \_\_\_\_\_

|    | A  | B  | C  | D  | E  | F  | G | H | I | J | K | L | M |
|----|----|----|----|----|----|----|---|---|---|---|---|---|---|
| 2  | 6  | 5  | 4  | 3  | 2  | 1  |   |   |   |   |   |   |   |
| 3  |    |    |    |    |    |    |   |   |   |   |   |   |   |
| 4  | 7  | 8  | 9  | 10 | 11 | 12 |   |   |   |   |   |   |   |
| 5  |    |    |    |    |    |    |   |   |   |   |   |   |   |
| 6  | 18 | 17 | 16 | 15 | 14 | 13 |   |   |   |   |   |   |   |
| 7  |    |    |    |    |    |    |   |   |   |   |   |   |   |
| 8  | 19 | 20 | 21 | 22 | 23 | 24 |   |   |   |   |   |   |   |
| 9  |    |    |    |    |    |    |   |   |   |   |   |   |   |
| 10 | 30 | 29 | 28 | 27 | 26 | 25 |   |   |   |   |   |   |   |
| 11 |    |    |    |    |    |    |   |   |   |   |   |   |   |
| 12 | 31 | 32 | 33 | 34 | 35 | 36 |   |   |   |   |   |   |   |
| 13 |    |    |    |    |    |    |   |   |   |   |   |   |   |

I, Randy Kolehouse, in a field survey on March 24, 19 94, do hereby certify that under requirements of P.A. 74, Michigan P.A. of 1970, the corner points mentioned in lines 1 and 2 above were in conformance with regulations and rules therefore as required in the current manual of survey instructions of the United States Department of the Interior, Bureau of Land Management or by a decree of a Court of Law and/or that the corner points mentioned in lines 3, 4 and 5 above were in conformance with the rules of Law and/or that the corner points mentioned in lines 3, 4 and 5 above were established, re-established, monumented, re-monumented, recovered, found as expressed below:

**NOTE: Not more than 4 corners, all in the same town and range, may be recorded on this certificate.**

A. Description of original monument and accessories and/or subsequent restoration:

|     |      |                |                   |  |
|-----|------|----------------|-------------------|--|
| F-5 | 1831 | G.L.O. Notes   | L. Lyon           | Set Post                                       |
|     | 1953 | Wit. Map       | K.C. Surveyor     | Bolt in Pave.                                  |
|     | 1974 | L.C.R.C. #859  | Medema Van Kooten | Bolt in Pave.                                  |
|     | 1982 | L.C.R.C. #3042 | Jonker            | Fnd. 1/2" Copper Rod in Mon. Box/Set K.C. Mon. |

P.A. 345 1990 KENT COUNTY  
PEER APPROVED 8/11/94  
CHAIRMAN Harry Huber

The position of this corner was previously approved by the Kent County Remonumentation Peer Group monumented by Jonker Land Surveys on 7/19/82 and was recorded per L.C.R.C. #3042.

B. Description of corner evidence found and/or method applied in restoring or reestablishing corner:

F-5 Found K.C. Monument per L.C.R.C. #3042 as set by Rob Jonker in place of 1/2" copper rod which he found in monument box which checks wits. map 1953 and L.C.R.C. #859.


L.C.R.C. #3042

Remon. tag on W side p. pole S 10° W 44.64' SE cor. brick on bldg. N 30° W 150.2'  
NE cor. sign (0.7' x 1.0') S 65° W 163.26' On N edge left turn lane  
Face conc. ROW marker S 00° W 49.68'  
SW cor. brick on bldg. N 50° E 154.05'

The selected location is accepted by me and is generally accepted by professional surveyors as the best available evidence of the position of the original corner.

C. Description of monument for corner and accessories established to perpetuate locating the position of the corner:

F-5 Standard Kent County Monument  
Nail & K.C. remon. tag on W side p. pole S 10° W 44.60'  
NE cor. sign (0.7' x 1.0') S 65° W 163.26'  
Face conc. ROW marker S 00° W 49.68'  
SW cor. brick on bldg. N 50° E 154.05'  
SE cor. brick on bldg. N 30° W 150.2'  
On N edge left turn lane

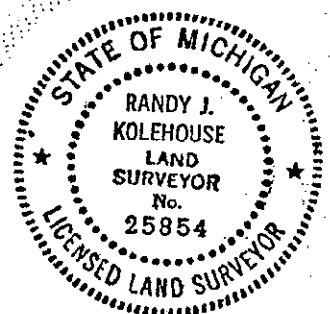

Signed by Randy Kolehouse  
Surveyor's Michigan License No. 25854

Date 11/21/94