

SURVEY & REMONUMENTATION

APR 28 1995

LAND CORNER RECORDATION CERTIFICATE Filing Requirement of Act 74, Mich. P.A. 1970 KENT COUNTY REMONUMENTATION

STATE OF MICHIGAN
COUNTY OF KENT
RECEIVED FOR RECORD

94 DEC -6 AM 8:58

For corners in **COMMISSION**

Kent (County)	Located in:	Corner Code #
1. Public Land Survey	T <u>6N</u> R <u>12W</u>	<u>F-8</u>
	T _____ R _____	_____
	T _____ R _____	_____
	T _____ R _____	_____
2. Property Controlling in Section	S _____ T _____ R _____	_____
	S _____ T _____ R _____	_____
3. Miscellaneous Property in Sec.	S _____ T _____ R _____	_____
	S _____ T _____ R _____	_____
4. Lot No. _____, Recorded Plat _____		
5. Private Claims _____		

W. J. Bond
REG. OF DEEDS

7738

Register of Deeds Stamp & File Number

I, Randy Kolehouse, in a field survey on June 14 19 94, do hereby certify that under requirements of P.A. 74 Michigan P.A. of 1970, the corner points mentioned in lines 1 and 2 above were in conformance with regulations and rules therefore as required in the current manual of survey instructions of the United States Department of the Interior, Bureau of Land Management or by a decree of a Court of Law and/or that the corner points mentioned in lines 3, 4 and 5 above were in conformance with the rules of the Michigan Board of Land Surveyors or by a Decree of a Court of Law; established, re-established, monumented, re-monumented, recovered, found as expressed below:

	A	B	C	D	E	F	G	H	I	J	K	L	M
2	6	5	4	3	2	1							
3													
4	7	8	9	10	11	12							
5													
6	18	17	16	15	14	13							
7													
8	19	20	21	22	23	24							
9													
10	30	29	28	27	26	25							
11													
12	31	32	33	34	35	36							
13													

NOTE: Not more than 4 corners, all in the same town and range, may be recorded on this certificate.

A. Description of original monument and accessories and/or subsequent restoration:

F-8 This corner was not originally set by the G.L.O.

1940	Survey Records	Williams & Works	Set Iron at Intersect. 1/4 Lines
1940-1960	Survey Records	Williams & Works	Used Iron as Set in 1940
1974	L.C.R.C. #766	Exxel Engineering	Concrete Monument

B. Description of corner evidence found and/or method applied in restoring or reestablishing corner:


F-8 Found concrete plat monument per L.C.R.C. #766. This location agrees with iron set by Williams & Works in 1940 and checks Williams & Works measurements to East 1/4 and West 1/4 corners $\pm 0.2'$ and distance to South 1/4 corner $1.0 \pm$. This point is 2.1' South and 1.0' West of intersection 1/4 lines. Accepted as Center Section.

P.A. 345 1990 KENT COUNTY
PEER APPROVED 7/28/94
CHAIRMAN *Harry Huber*

C. Description of monument for corner and accessories established to perpetuate locating the position of the corner:

F-8 Replaced concrete plat monument with a Standard 4" x 30" Kent County Monument (Harrison).

- SE corner hse. fndn. N 10° W 42.67'
- Nail & K.C. remon. tag in SE side 12" Willow N 30° E 30.63'
- Nail & K.C. remon. tag in S side 15" Ash N 70° W 71.35'
- Nail & K.C. remon. tag in S side 6" Ash N 75° W 26.95'
- Nail & K.C. remon. tag in NW side 28" Sycamore S 40° W 56.78'
- SW corner hse. fndn. N 50° W 72.46'

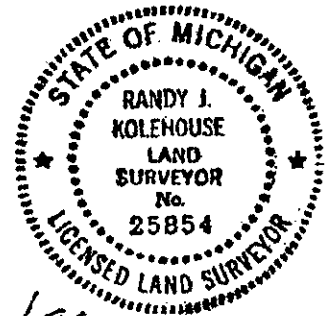

Signed by *Randy J. Kolehouse* Date 12/1/94
Surveyor's Michigan License No. 25854