

SURVEY & REMONUMENTATION

Kent County Remonumentation

STATE OF MICHIGAN
COUNTY OF KENT
RECEIVED FOR RECORD

APR 28 1995

LAND CORNER RECORDATION CERTIFICATE
Filing Requirement of Act 74, Mich. P.A. 1970

NOV 29 AM 9:19

For corners in
Kent **COMMISSION**
(County)

Located In:

Corner Code ##

Tim Bond
REG. OF DEEDS

- | | | |
|---------------------------------------|--------------------------|------------|
| 1. Public Land Survey | T <u>6N</u> R <u>12W</u> | <u>F-9</u> |
| | T _____ R _____ | _____ |
| | T _____ R _____ | _____ |
| | T _____ R _____ | _____ |
| 2. Property Controlling in Section | S _____ T _____ R _____ | _____ |
| | S _____ T _____ R _____ | _____ |
| 3. Miscellaneous Property in Sec. | S _____ T _____ R _____ | _____ |
| | S _____ T _____ R _____ | _____ |
| 4. Lot No. _____, Recorded Plat _____ | | |
| 5. Private Claims _____ | | |

7440

Register of Deeds Stamp & File Number

I, Randy Kolehouse, in a field survey on May 18, 19 94, do hereby certify that under requirements of P.A. 74, Michigan P.A. of 1970, the corner points mentioned in lines 1 and 2 above were in conformance with regulations and rules therefore as required in the current manual of survey instructions of the United States Department of the Interior, Bureau of Land Management or by a decree of a Court of Law and/or that the corner points mentioned in lines 3, 4 and 5 above were in conformance with the rules of the Michigan Board of Land Surveyors or by a Decree of a Court of Law; established, re-established, monumented, re-monumented, recovered, found as expressed below:

	A	B	C	D	E	F	G	H	I	J	K	L	M
2	6	5	4	3	2	1							
3													
4	7	8	9	10	11	12							
5													
6	13	17	16	15	14	13							
7													
8	19	20	21	22	23	24							
9													
10	30	29	28	27	26	25							
11													
12	31	32	33	34	35	36							
13													

NOTE: Not more than 4 corners, all in the same town and range, may be recorded on this certificate.

A. Description of original monument and accessories and/or subsequent restoration:

F-9	1831	G.L.O. Notes	L. Lyon	Set Post
	N/A	Wit. Map	K.C. Surveyor	BR Spike
	1971	L.C.R.C. #53	Williams & Works	BT Spike C/L R.R.
	1973	Survey Records	Exxel Engineering	BT Spike C/L R.R.
	1981	L.C.R.C. #1966	Exxel Engineering	Fnd. Iron/Set K.C. Mon.

P.A. 345 1990 KENT COUNTY
PEER APPROVED 7/28/94
CHAIRMAN *Harry Huber*

This corner was originally approved by the Kent County Remonumentation Peer Group and monumented by Exxel Engineering, Inc., on 8/14/81 and was recorded per L.C.R.C. #1966.

B. Description of corner evidence found and/or method applied in restoring or reestablishing corner:


F-9 Found K.C. Monument per L.C.R.C. #1966 as set by Exxel Engineering in place of an iron they found which checked 1974 Exxel Engineering survey records which agree with L.C.R.C. #1971 & K.C. wit. map.
L.C.R.C. #1966

- SW cor. concrete CP pad N 44° E 85.96'
- C/L top of hydrant N 65° W 114.45'
- SW cor. catch basin (at back of curb) S 10° E 37.56'
- C/L M.H. in walk S 61° E 98.23'
- Chiseled "X" in top curb at East end median island N 85° E 67.77'
- Cor. is 0.1' ± South of the back of the conc. curb on S'ly side of med.

The selected location is accepted by me and is generally accepted by professional surveyors as the best available evidence of the position of the original corner.

C. Description of monument for corner and accessories established to perpetuate locating the position of the corner:

F-9 Standard Kent County Monument
SW cor. concrete CP pad N 44° E 85.96'
C/L top of hydrant N 65° W 114.45'
SW cor. catch basin (at back of curb) S 10° E 37.56'
C/L M.H. in walk S 61° E 98.23'
Chiseled "X" in top curb at East end median island N 85° E 67.77'
Cor. is 0.1' ± South of the back of the concrete curb on S'ly side of median

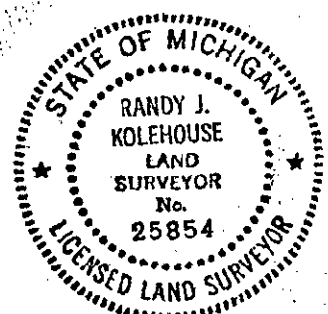

Signed by *Randy J. Kolehouse*
Surveyor's Michigan License No. 25854

Date 11/21/94