

SURVEY & REMONUMENTATION

Kent County Remonumentation

STATE OF MICHIGAN
COUNTY OF KENT
RECEIVED FOR RECORD

APR 28 1995

LAND CORNER RECORDATION CERTIFICATE

Filing Requirement of Act 74, Mich. P.A. 1970

94 NOV 29 AM 9:19

For corners in
Kent **COMMISSION**
(County)

| Located In: | Corner Code # |
|--|---------------|
| T <u>6N</u> R <u>12W</u> | <u>F-11</u> |
| T _____ R _____ | _____ |
| T _____ R _____ | _____ |
| T _____ R _____ | _____ |
| T _____ R _____ | _____ |
| 2. Property Controlling in Section S _____ T _____ R _____ | _____ |
| S _____ T _____ R _____ | _____ |
| 3. Miscellaneous Property in Sec. S _____ T _____ R _____ | _____ |
| S _____ T _____ R _____ | _____ |

W. J. Bond
REG. OF DEEDS

7441

Register of Deeds Stamp & File Number

4. Lot No. _____, Recorded Plat _____
5. Private Claims _____

| | A | B | C | D | E | F | G | H | I | J | K | L | M |
|----|----|----|----|----|----|----|---|---|---|---|---|---|---|
| 2 | 6 | 5 | 4 | 3 | 2 | 1 | | | | | | | |
| 3 | | | | | | | | | | | | | |
| 4 | 7 | 8 | 9 | 10 | 11 | 12 | | | | | | | |
| 5 | | | | | | | | | | | | | |
| 6 | 18 | 17 | 16 | 15 | 14 | 13 | | | | | | | |
| 7 | | | | | | | | | | | | | |
| 8 | 19 | 20 | 21 | 22 | 23 | 24 | | | | | | | |
| 9 | | | | | | | | | | | | | |
| 10 | 30 | 29 | 28 | 27 | 26 | 25 | | | | | | | |
| 11 | | | | | | | | | | | | | |
| 12 | 31 | 32 | 33 | 34 | 35 | 36 | | | | | | | |
| 13 | | | | | | | | | | | | | |

I, Randy Kolehouse, in a field survey on March 24, 1994, do hereby certify that under requirements of P.A. 74, Michigan P.A. of 1970, the corner points mentioned in lines 1 and 2 above were in conformance with regulations and rules therefore as required in the current manual of survey instructions of the United States Department of the Interior, Bureau of Land Management or by a decree of a Court of Law and/or that the corner points mentioned in lines 3, 4 and 5 above were in conformance with the rules of the Michigan Board of Land Surveyors or by a Decree of a Court of Law; established, re-established, monumented, re-monumented, recovered, found as expressed below:

NOTE: Not more than 4 corners, all in the same town and range, may be recorded on this certificate.

A. Description of original monument and accessories and/or subsequent restoration:

| F-11 | 1831 | G.L.O. Notes | L. Lyon | Set Post |
|------|------|----------------|-------------------|----------------------------------|
| | 1953 | Wit. Map | K.C. Surveyor | 1/2" Iron |
| | 1973 | L.C.R.C. #371 | Exxel Engineering | 1/2" Iron |
| | 1981 | L.C.R.C. #1832 | Exxel Engineering | Fnd. 1/2" Iron/Set K.C. Monument |

This corner was originally approved by the Kent County Remonumentation Peer Group and monumented by Exxel Engineering, Inc., on 9/2/81 and was recorded per L.C.R.C. #1832.

B. Description of corner evidence found and/or method applied in restoring or reestablishing corner:

F-11 Found K.C. Monument in C/L 52nd Street running E-W per L.C.R.C. #1832 as set by Exxel Engineering in place as a 1/2" iron they found which checked Williams & Works survey records 1947, wit. map 1953 and L.C.R.C. #371.

L.C.R.C. #1832


SW corner (2' above ground) frame garage N 18° E 115.59'
NE corner brick house S 50° E 113.68'
NW corner brick garage S 10° E 77.50'
P.K. & K.C. remon. tag in NW side p. pole S 55° W 55.00'

P.A. 345 1990 KENT COUNTY
PEER APPROVED 7/28/94
CHAIRMAN *Fanny Huber*

The selected location is accepted by me and is generally accepted by professional surveyors as the best available evidence of the position of the original corner.

C. Description of monument for corner and accessories established to perpetuate locating the position of the corner:

F-11 Standard Kent County Monument
SW corner (2' above ground) frame garage N 18° E 115.59'
NE corner brick house S 50° E 113.68'
NW corner brick garage S 10° E 77.50'
P.K. & K.C. remon. tag in NW side p. pole S 55° W 55.00'
Nail & K.C. remon tag in SE side p. pole N 25° E 34.01'

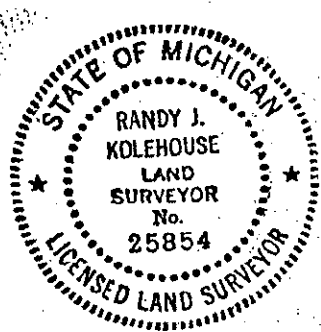

Signed by *Randy J. Kolehouse*
Surveyor's Michigan License No. 25854

Date 11/21/94