

SURVEY & REMONUMENTATION

Kent County Remonumentation

STATE OF MICHIGAN
COUNTY OF KENT
RECEIVED FOR RECORD

APR 28 1995

LAND CORNER RECORDATION CERTIFICATE
Filing Requirement of Act 74, Mich. P.A. 1970

NOV 29 AM 9:19

For corners in
Kent **COMMISSION**
(County)

Located In:

Corner Code #

W. J. Bond
REG. OF DEEDS

- | | | | | | |
|------------------------------------|---|-----------|---|------------|------------|
| 1. Public Land Survey | T | <u>6N</u> | R | <u>12W</u> | <u>G-1</u> |
| | T | _____ | R | _____ | _____ |
| | T | _____ | R | _____ | _____ |
| | T | _____ | R | _____ | _____ |
| 2. Property Controlling in Section | S | _____ | T | _____ | _____ |
| | S | _____ | T | _____ | _____ |
| 3. Miscellaneous Property in Sec. | S | _____ | T | _____ | _____ |
| | S | _____ | T | _____ | _____ |

7443

Register of Deeds Stamp & File Number

4. Lot No. _____, Recorded Plat _____
5. Private Claims _____

	A	B	C	D	E	F	G	H	I	J	K	L	M
2	6	5	4	3	2	1							
3													
4	7	8	9	10	11	12							
5													
6	18	17	16	15	14	13							
7													
8	19	20	21	22	23	24							
9													
10	30	29	28	27	26	25							
11													
12	31	32	33	34	35	36							
13													

I, Randy Kolehouse, in a field survey on September 1, 19 94, do hereby certify that under requirements of P.A. 74, Michigan P.A. of 1970, the corner points mentioned in lines 1 and 2 above were in conformance with regulations and rules therefore as required in the current manual of survey instructions of the United States Department of the Interior, Bureau of Land Management or by a decree of a Court of Law and/or that the corner points mentioned in lines 3, 4 and 5 above were in conformance with the rules of the Michigan Board of Land Surveyors or by a Decree of a Court of Law; established, re-established, monumented, re-monumented, recovered, found as expressed below:

NOTE: Not more than 4 corners, all in the same town and range, may be recorded on this certificate.

A. Description of original monument and accessories and/or subsequent restoration:

G-1	1831	G.L.O. Notes	L. Lyon	Set Post
	1894-1939	Survey Records	Williams & Works	Iron Bolt
	1939	Wit. Map	K.C. Surveyor	Iron
	1985	L.C.R.C. #4123	William Byl	Set K.C. Mon.
	1990	L.C.R.C. #5566	Thomas Starr	K.C. Mon.

P.A. 345 1990 KENT COUNTY
PEER APPROVED 9/22/94
CHAIRMAN Stanley Huber

The position of this corner was previously approved by the Kent County Remonumentation Peer Group monumented by William Byl on 1/8/85 and was recorded per L.C.R.C. #4123.


B. Description of corner evidence found and/or method applied in restoring or reestablishing corner:

- G-1 Found K.C. Monument in Gypsum fill area per L.C.R.C.'s #4123 and #5566 as set by William Byl using survey records from Williams & Works 1894-1939.
- | | |
|---|---|
| L.C.R.C. #5566 | L.C.R.C. #2123 |
| Nail & K.C. remon. tag in E side 6" Poplar | Nail & K.C. remon. tag in E side 6" Poplar |
| Nail & K.C. remon. tag in W side power pole | Nail & K.C. remon. tag in W side power pole |

The selected location is accepted by me and is generally accepted by professional surveyors as the best available evidence of the position of the original corner.

C. Description of monument for corner and accessories established to perpetuate locating the position of the corner:

- G-1 Standard Kent County Monument
- Nail & K.C. remon. tag in N side 8" Poplar N 90° E 71.46'
 - Nail & K.C. remon. tag in N side 4" Ash N 65° W 36.88'
 - Nail & K.C. remon. tag in NE side 4" Poplar S 40° E 38.74'
 - Nail & K.C. remon. tag in E side 6" Poplar N 30° E 51.42'
 - Nail & K.C. remon. tag in W side power pole S 55° E 133.10'

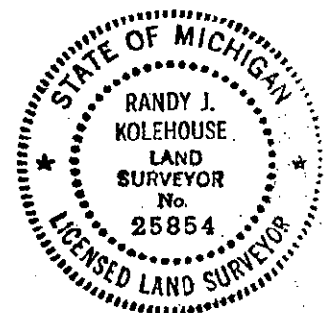

Signed by Randy J. Kolehouse
Surveyor's Michigan License No. 25854

Date 11/21/94