

20
2

SURVEY & REMONUMENTATION

Kent County Remonumentation

STATE OF MICHIGAN
COUNTY OF KENT
RECEIVED FOR RECORD

APR 28 1995

LAND CORNER RECORDATION CERTIFICATE 94 NOV 29 AM 9:19
Filing Requirement of Act 74, Mich. P.A. 1970

For corners in
Kent **COMMISSION**
(County)

Located In:	Corner Code #
T <u>6N</u> R <u>12W</u>	<u>G-3</u>
T _____ R _____	_____
T _____ R _____	_____
T _____ R _____	_____
T _____ R _____	_____
S _____ T _____ R _____	_____
S _____ T _____ R _____	_____
S _____ T _____ R _____	_____
S _____ T _____ R _____	_____

W. J. Bond
REG. OF DEEDS

7445

Register of Deeds Stamp & File Number

- 4. Lot No. _____, Recorded Plat _____
- 5. Private Claims _____

A	B	C	D	E	F	G	H	I	J	K	L	M
2	6	5	4	3	2	1						
3												
4	7	8	9	10	11	12						
5												
6	18	17	16	15	14	13						
7												
8	19	20	21	22	23	24						
9												
10	30	29	28	27	26	25						
11												
12	31	32	33	34	35	36						
13												

I, Randy Kolehouse, in a field survey on April 21, 19 94, do hereby certify that under requirements of P.A. 74, Michigan P.A. of 1970, the corner points mentioned in lines 1 and 2 above were in conformance with regulations and rules therefore as required in the current manual of survey instructions of the United States Department of the Interior, Bureau of Land Management or by a decree of a Court of Law and/or that the corner points mentioned in lines 3, 4 and 5 above were in conformance with the rules of the Michigan Board of Land Surveyors or by a Decree of a Court of Law; established, re-established, monumented, re-monumented, recovered, found as expressed below:

NOTE: Not more than 4 corners, all in the same town and range, may be recorded on this certificate.

A. Description of original monument and accessories and/or subsequent restoration:

G-3	1831	G.L.O. Notes	L. Lyon	Set Post
	N/A	Wit. Map	K.C. Surveyor	Iron
	1963	Wit. Record	MDSH	3/4" Iron
	1977	L.C.R.C. #1020	MDSH	3/4" Iron
	1982	L.C.R.C. #2700	Jonker	Fnd. 3/4" Iron in Mon. Box/Set K.C. Mon.

The position of this corner was previously approved by the Kent County Remonumentation Peer Group monumented by Jonker Land Surveys on 3/8/82 and was recorded per L.C.R.C. #2700.

B. Description of corner evidence found and/or method applied in restoring or reestablishing corner:

G-3 Found K.C. Monument per L.C.R.C. #2700 as set by Rob Jonker in place of a 3/4" iron in monument box over a 3/4" iron in stones which checked with L.C.R.C. #1020.

L.C.R.C. #2700


- MSHD tag S side 42" Oak N 85° E 32.6'
- MSHD tag SE side p. pole S 30° W 48.02'
- SW cor. hse. fndn. N 75° E 51.13'
- NW cor. hse. fndn. S 40° E 103.38'
- Vertical metal corner at SW cor. block bldg. N 10° E 180.2'

P.A. 345 1990 KENT COUNTY
PEER APPROVED 8/11/94
CHAIRMAN *Harry Huber*

The selected location is accepted by me and is generally accepted by professional surveyors as the best available evidence of the position of the original corner.

C. Description of monument for corner and accessories established to perpetuate locating the position of the corner:

- G-3 Standard Kent County Monument
 - Nail & MSHD tag S side 42" Oak N 85° E 32.6'
 - Nail & MSHD tag SE side p. pole S 30° W 48.02'
 - SW cor. hse. fndn. N 75° E 51.13'
 - NW cor. hse. fndn. S 40° E 103.38'
 - Vertical metal corner at SW cor. block bldg. N 10° E 180.2'

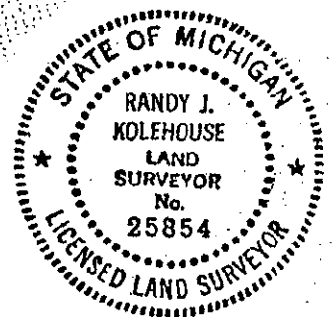

Signed by Randy J. Kolehouse
Surveyor's Michigan License No. 25854

Date 11/21/94