

SURVEY & REMONUMENTATION

Kent County Remonumentation

STATE OF MICHIGAN
COUNTY OF KENT
RECEIVED FOR RECORD

APR 28 1995

LAND CORNER RECORDATION CERTIFICATE
Filing Requirement of Act 74, Mich. P.A. 1970

NOV 29 AM 9:19

For corners in

Kent **COMMISSION**
(County)

Located In:

Corner Code #

Tim J. Gland
REG. OF DEEDS

- 1. Public Land Survey T 6N R 12W
- T _____ R _____
- T _____ R _____
- T _____ R _____
- 2. Property Controlling S _____ T _____ R _____
- in Section S _____ T _____ R _____
- 3. Miscellaneous S _____ T _____ R _____
- Property in Sec. S _____ T _____ R _____

G-4

7446

Register of Deeds Stamp & File Number

- 4. Lot No. _____, Recorded Plat _____
- 5. Private Claims _____

A	B	C	D	E	F	G	H	I	J	K	L	M
2	6	5	4	3	2	1						
3												
4	7	8	9	10	11	12						
5												
6	18	17	16	15	14	13						
7												
8	19	20	21	22	23	24						
9												
10	30	29	28	27	26	25						
11												
12	31	32	33	34	35	36						
13												

I, Randy Kolehouse, in a field survey on April 21, 19 94, do hereby certify that under requirements of P.A. 74, Michigan P.A. of 1970, the corner points mentioned in lines 1 and 2 above were in conformance with regulations and rules therefore as required in the current manual of survey instructions of the United States Department of the Interior, Bureau of Land Management or by a decree of a Court of Law and/or that the corner points mentioned in lines 3, 4 and 5 above were in compliance with the rules of the Michigan Board of Land Surveyors or by a Decree of a Court of Law; established, re-established, monumented, re-monumented, recovered, found as expressed below:

NOTE: Not more than 4 corners, all in the same town and range, may be recorded on this certificate.

A. Description of original monument and accessories and/or subsequent restoration:

G-4	1831	G.L.O. Notes	L. Lyon	Set Post	P.A. 345 1990 KENT COUNTY
	1933	Wit. Map	K.C. Surveyor	Iron	PEER APPROVED <u>8/11/94</u>
	1960	Wit. Map	K.C. Surveyor	Mon. Box	CHAIRMAN <u>Harry Huber</u>
	1976	L.C.R.C. #914	Williams & Works	P.K. Nail	
	1978	Survey Records	Exxel Engineering	Iron	
	1982	L.C.R.C. #3035	Jonker	Fnd. Wood Hub/Set K.C. Mon.	

The position of this corner was previously approved by the Kent County Remonumentation Peer Group monumented by Jonker Land Surveys on 7/19/82 and was recorded per L.C.R.C. #3035.

B. Description of corner evidence found and/or method applied in restoring or reestablishing corner:

G-4 Found K.C. Monument at C/L Byron Center Ave. running N-S at Porter Street running E-W per L.C.R.C. #3035 which was set by Rob Jonker in place of a 2x2x12 wood hub which he found to check wits. 1933 and 1960, wit. map and L.C.R.C. #914 and Exxel Engineering survey records.


L.C.R.C. #3035

Nail & K.C. remon. tag NW side p. pole S 35° W 50.05'	SW cor. brick on bldg. N 50° W 56.78'
Nail & K.C. remon. tag SW side p. pole S 65° E 62.60'	C/L M.H. N 60° E 18.58'
SW cor. brick on fire station N 30° E 80.00'	C/L M.H. S 40° W 6.25'

The selected location is accepted by me and is generally accepted by professional surveyors as the best available evidence of the position of the original corner.

C. Description of monument for corner and accessories established to perpetuate locating the position of the corner:

G-4 Standard Kent County Monument
Nail & K.C. remon. tag NW side p. pole S 35° W 50.05'
Nail & K.C. remon. tag SW side p. pole S 65° E 62.60'
SW cor. brick on fire station N 30° E 80.00'
SW cor. brick on bldg. N 50° W 56.78'
C/L M.H. N 60° E 18.58'
C/L M.H. S 40° W 6.25'

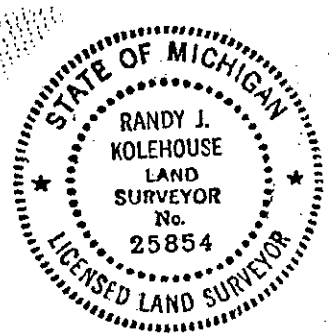

Signed by Randy J. Kolehouse
Surveyor's Michigan License No. 25854

Date 11/21/94