

SURVEY & REMONUMENTATION

Kent County Remonumentation

STATE OF MICHIGAN
COUNTY OF KENT
RECEIVED FOR RECORD

APR 28 1995

LAND CORNER RECORDATION CERTIFICATE
Filing Requirement of Act 74, Mich. P.A. 1970

NOV 29 AM 9:19

For corners in **COMMISSION**


Kent (County)	Located In:	Corner Code -##
1. Public Land Survey	T <u>6N</u> R <u>12W</u>	<u>G-7</u>
	T _____ R _____	_____
	T _____ R _____	_____
	T _____ R _____	_____
2. Property Controlling in Section	S _____ T _____ R _____	_____
	S _____ T _____ R _____	_____
3. Miscellaneous Property in Sec.	S _____ T _____ R _____	_____
	S _____ T _____ R _____	_____

Tim J. Bond
REG. OF DEEDS

7449

Register of Deeds Stamp & File Number

- 4. Lot No. _____, Recorded Plat _____
- 5. Private Claims _____

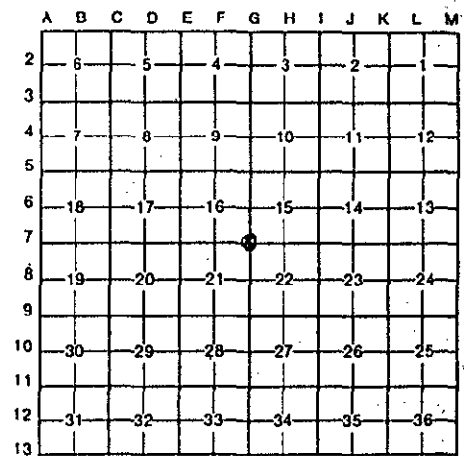

I, Randy Kolehouse, in a field survey on March 29, 19 94, do hereby certify that under requirements of P.A. 74, Michigan P.A. of 1970, the corner points mentioned in lines 1 and 2 above were in conformance with regulations and rules therefore as required in the current manual of survey instructions of the United States Department of the Interior, Bureau of Land Management or by a decree of a Court of Law and/or that the corner points mentioned in lines 3, 4 and 5 above were in conformance with the rules of the Michigan Board of Land Surveyors or by a Decree of a Court of Law; established, re-established, monumented, re-monumented, recovered, found as expressed below:

NOTE: Not more than 4 corners, all in the same town and range, may be recorded on this certificate.

A. Description of original monument and accessories and/or subsequent restoration:

G-7	1831	G.L.O. Notes	L. Lyon	Set Post
	1933	Wit Map	KC Surveyor	"+" in Pavement
	1956	Wit Map	KC Surveyor	"+" in Pavement
	1957	Wit Map	KC Surveyor	"+" in Pavement
	1976	L.C.R.C. #912	Greer	PK Nail
	1982	L.C.R.C. #2817	Jonker	Fnd PK & Iron; Set KC Monument

This corner was originally approved by the Kent County Remonumentation Peer Group and monumented by Jonker Land Surveys on 3/22/82 and was recorded per L.C.R.C. #2817.

B. Description of corner evidence found and/or method applied in restoring or reestablishing corner:

G-7 Found KC Monument at centerline Byron Center Ave. running N-S and 36th Street, running E-W per L.C.R.C. #2817 as set by Rob Jonker in place of a PK nail over a 1" iron in bit pave over 4" concrete road which checks 1957 Wit Map & L.C.R.C. 912.

L.C.R.C. #2817

- SE cor. bldg. fndn. N 52° W 100.50'
- C/L M.H. N 40° W 6.45'
- C/L M.H. N 60° E 16.46'
- C/L M.H. S 40° W 24.21'

P.A. 345 1990 KENT COUNTY
PEER APPROVED 8/11/94
CHAIRMAN *Harry Huber*

The selected location is accepted by me and is generally accepted by professional surveyors as the best available evidence of the position of the original corner.

C. Description of monument for corner and accessories established to perpetuate locating the position of the corner:

- G-7 Standard Kent County Monument
- SE cor. bldg. fndn. N 52° W 100.50'
- C/L M.H. N 40° W 6.45'
- C/L M.H. N 60° E 16.46'
- C/L M.H. S 40° W 24.21'



Signed by *Randy J. Kolehouse*
Surveyor's Michigan License No. 25854

Date 11/21/94