

SURVEY & REMONUMENTATION

Kent County Remonumentation

STATE OF MICHIGAN
COUNTY OF KENT
RECEIVED FOR RECORD

APR 28 1995

LAND CORNER RECORDATION CERTIFICATE 94 NOV 29 AM 9:19
Filing Requirement of Act 74, Mich. P.A. 1970

For corners in Kent **COMMISSION**

Wendy J. Dand
REG. OF DEEDS

(County)	Located In:	Corner Code #
1. Public Land Survey	T 6N R 12W	G-8
	T R	
	T R	
	T R	
2. Property Controlling in Section	S T R	
	S T R	
3. Miscellaneous Property in Sec.	S T R	
	S T R	

7450

Register of Deeds Stamp & File Number

- 4. Lot No. _____, Recorded Plat _____
- 5. Private Claims _____

	A	B	C	D	E	F	G	H	I	J	K	L	M
2	6	5	4	3	2	1							
3													
4	7	8	9	10	11	12							
5													
6	18	17	16	15	14	13							
7													
8	19	20	21	22	23	24							
9													
10	30	29	28	27	26	25							
11													
12	31	32	33	34	35	36							
13													

I, Randy Kolehouse, in a field survey on May 18, 19 94, do hereby certify that under requirements of P.A. 74, Michigan P.A. of 1970, the corner points mentioned in lines 1 and 2 above were in conformance with regulations and rules therefore as required in the current manual of survey instructions of the United States Department of the Interior, Bureau of Land Management or by a decree of a Court of Law and/or that the corner points mentioned in lines 3, 4 and 5 above were in conformance with the rules of the Michigan Board of Land Surveyors or by a Decree of a Court of Law; established, re-established, monumented, re-monumented, recovered, found as expressed below:

NOTE: Not more than 4 corners, all in the same town and range, may be recorded on this certificate.

A. Description of original monument and accessories and/or subsequent restoration:

G-8	1831	G.L.O. Notes	L. Lyon	Set Post
	1957	Wit. Map	K.C. Surveyor	Iron
	1974	L.C.R.C. #686	Exxel Eng.	Iron
	1982	L.C.R.C. #2808	Jonker	Fnd Flat Iron/Set K.C. Mon.

This corner was originally approved by the Kent County Remonumentation Peer Group and monumented by Jonker Land Surveys on 4/28/82 and was recorded per L.C.R.C. #2808.

B. Description of corner evidence found and/or method applied in restoring or reestablishing corner:

G-8 K.C. Monument set in L.C.R.C. #2808 has been destroyed. Set PK nail per Wits L.C.R.C. #2808 in centerline Byron Center Ave. running N-S. This point was monument by Rob Jonker in place of a 1/2" x 1" x 12" flat Iron over a 1/2" x 3" x 24" flat Iron which he found and checked with 1937 Wit. Map and L.C.R.C. #686.

L.C.R.C. #2808


- SW corner hse. fnd. N 47° E 98.90'
- NW corner hse. fnd. S 75° E 79.18'2
- NW corner hse. fnd. S 45° E 101.80'

P.A. 345 1990 KENT COUNTY
PEER APPROVED 7/28/94
CHAIRMAN *Harry Huber*

The selected location is accepted by me and is generally accepted by professional surveyors as the best available evidence of the position of the original corner.

C. Description of monument for corner and accessories established to perpetuate locating the position of the corner:

- G-8 Set Standard Kent County Monument
 - Nail & K.C. remon. tag in SE side 20" Oak S 55° W 66.48'
 - Nail & K.C. remon. tag in NE side 12" Oak N 40° W 79.07'
 - SW corner hse. fnd. N 47° E 98.90'
 - NW corner hse. fnd. S 75° E 79.18'2
 - NW corner hse. fnd. S 45° E 101.80'

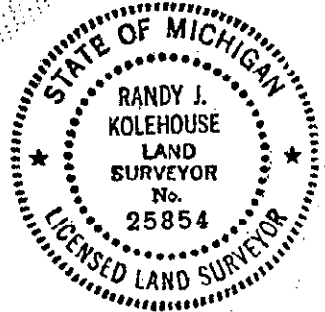

Signed by *Randy J. Kolehouse*
Surveyor's Michigan License No. 25854

Date 11/21/94