

SURVEY & REMONUMENTATION

Kent County Remonumentation

STATE OF MICHIGAN
COUNTY OF KENT
RECEIVED FOR RECORD

APR 28 1995

LAND CORNER RECORDATION CERTIFICATE 94 NOV 29 AM 9:19
Filing Requirement of Act 74, Mich. P.A. 1970

For corners in **COMMISSION**

Kent (County)	Located In:	Corner Code #
1. Public Land Survey	T <u>6N</u> R <u>12W</u>	<u>G-9</u>
	T _____ R _____	_____
	T _____ R _____	_____
	T _____ R _____	_____
2. Property Controlling in Section	S _____ T _____ R _____	_____
	S _____ T _____ R _____	_____
3. Miscellaneous Property in Sec.	S _____ T _____ R _____	_____
	S _____ T _____ R _____	_____
4. Lot No. _____, Recorded Plat _____		
5. Private Claims _____		

W. J. Bond
REG. OF DEEDS

7451

Register of Deeds Stamp & File Number

I, Randy Kolehouse, in a field survey on March 29, 19 94, do hereby certify that under requirements of P.A. 74, Michigan P.A. of 1970, the corner points mentioned in lines 1 and 2 above were in conformance with regulations and rules therefore as required in the current manual of survey instructions of the United States Department of the Interior, Bureau of Land Management or by a decree of a Court of Law and/or that the corner points mentioned in lines 3, 4 and 5 above were in conformance with the rules of the Michigan Board of Land Surveyors or by a Decree of a Court of Law; established, re-established, monumented, re-monumented, recovered, found as expressed below:

	A	B	C	D	E	F	G	H	I	J	K	L	M
2	6		5		4		3		2		1		
3													
4	7		8		9		10		11		12		
5													
6	18		17		16		15		14		13		
7													
8	19		20		21		22		23		24		
9													
10	30		29		28		27		26		25		
11													
12	31		32		33		34		35		36		
13													

NOTE: Not more than 4 corners, all in the same town and range, may be recorded on this certificate.

A. Description of original monument and accessories and/or subsequent restoration:

G-9	1831	G.L.O. Notes	L. Lyon	Set Post
	1933	Wit Map	KC Surveyor	Iron in Conc
	1957	Wit Map	KC Surveyor	Iron in Conc
	1971	L.C.R.C. #53	Williams & Works	Iron
	1981	L.C.R.C. #2350	Exxel Eng	1" Iron in MB/Set K.C. Mon.

This corner was originally approved by the Kent County Remonumentation Peer Group and monumented by Exxel Engineering, Inc., on 9/24/81 and was recorded per L.C.R.C. #2350.

B. Description of corner evidence found and/or method applied in restoring or reestablishing corner:

G-9 Found KC Monument in centerline of Byron Center Ave. running N-S and 44th St. running E-W per L.C.R.C. #2350 as set by Exxel Eng in place of a 1" Iron they found and checked with L.C.R.C. #53 and Exxel Eng survey records.


L.C.R.C. #2350
C/L of monument box North 0.13'
Spike and K.C. remon. tag in SE side 24" Oak S 37° W 106.56'
Spike and K.C. remon. tag in NW side 40" Oak S 62° W 144.79'
NE cor. hse. fndn. N 34° W 150.0'
SW cor. brick garage station N 39° E 135.11'

P.A. 345 1990 KENT COUNTY
PEER APPROVED 7/28/94
CHAIRMAN *Harry Thubert*

The selected location is accepted by me and is generally accepted by professional surveyors as the best available evidence of the position of the original corner.

C. Description of monument for corner and accessories established to perpetuate locating the position of the corner:

G-9 Standard Kent County Monument
C/L of monument box North 0.13'
Nail and K.C. remon. tag in SE side 24" Oak S 37° W 106.56'
Nail and K.C. remon. tag in NW side 40" Oak S 62° W 144.79'
NE cor. hse. fndn. N 34° W 150.0'
SW cor. brick garage station N 39° E 135.11'

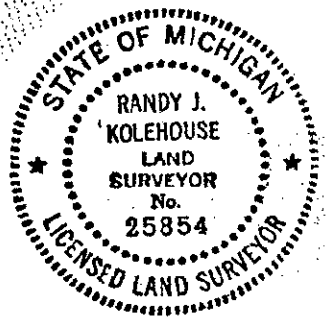

Signed by Randy J. Kolehouse
Surveyor's Michigan License No. 25854

Date 11/21/94