

**SURVEY & REMONUMENTATION**

APR 28 1995

Kent County Remonumentation

STATE OF MICHIGAN  
COUNTY OF KENT  
RECEIVED FOR RECORD

**COMMISSION**

**LAND CORNER RECORDATION CERTIFICATE**  
Filing Requirement of Act 74, Mich. P.A. 1970

94 NOV 29 AM 9:22

For corners in

Kent (County)	Located In:	Corner Code #
1. Public Land Survey	T <u>6N</u> R <u>12W</u>	<u>G-13</u>
	T _____ R _____	_____
	T _____ R _____	_____
	T _____ R _____	_____
2. Property Controlling in Section	S _____ T _____ R _____	_____
	S _____ T _____ R _____	_____
3. Miscellaneous Property in Sec.	S _____ T _____ R _____	_____
	S _____ T _____ R _____	_____

*W. J. Colehouse*  
REG. OF DEEDS

**7455**  
Register of Deeds Stamp & File Number

- 4. Lot No. \_\_\_\_\_, Recorded Plat \_\_\_\_\_
- 5. Private Claims \_\_\_\_\_

	A	B	C	D	E	F	G	H	I	J	K	L	M
2	6	5	4	3	2	1							
3													
4	7	8	9	10	11	12							
5													
6	18	17	16	15	14	13							
7													
8	19	20	21	22	23	24							
9													
10	30	29	28	27	26	25							
11													
12	31	32	33	34	35	36							
13													

I, Randy Kolehouse, in a field survey on March 24, 19 94, do hereby certify that under requirements of P.A. 74, Michigan P.A. of 1970, the corner points mentioned in lines 1 and 2 above were in conformance with regulations and rules therefore as required in the current manual of survey instructions of the United States Department of the Interior, Bureau of Land Management or by a decree of a Court of Law and/or that the corner points mentioned in lines 3, 4 and 5 above were in conformance with the rules of the Michigan Board of Land Surveyors or by a Decree of a Court of Law; established, re-established, monumented, re-monumented, recovered, found as expressed below:

**NOTE: Not more than 4 corners, all in the same town and range, may be recorded on this certificate.**

**A. Description of original monument and accessories and/or subsequent restoration:**

G-13	1831	G.L.O. Notes	L. Lyon	Set Post
	1933	Wit. Map	K.C. Surveyor	"+" in Pavement
	1957	Wit. Map	K.C. Surveyor	Iron in M.B.
	1975	L.C.R.C. #894	Exxel Eng.	Iron in M.B.
	1981	L.C.R.C. #1685	Williams & Works	Fnd Iron in M.B./Set KC Mon.

This corner was originally approved by the Kent County Remonumentation Peer Group and monumented by Williams & Works, Inc., on 5/1/81 and was recorded per L.C.R.C. #1685.

**B. Description of corner evidence found and/or method applied in restoring or reestablishing corner:**

G-13 Found KC Monument in centerline of Byron Center Ave. running N-S per L.C.R.C. #1685 as set by Williams & Works in place of a 3/4" iron in M.B. which they found and checked with 1933 and 1957 Wit Map and L.C.R.C. #894.

L.C.R.C. #1685


- Nail & K.C. remon. tag E side 38" Sycamore N 30° E 59.09'
- Nail & K.C. remon. tag S side 8" Elm S 50° E 44.46'
- Nail & K.C. remon. tag S side 4" Elm N 70° E 43.23'
- Top C/L con. ROW mon. East 18.77'
- SE leg of C.P. tower (at ground) S 25° W 131.08'
- NW leg of C.P. tower (at ground) S 55° W 128.28'

P.A. 345 1990 KENT COUNTY  
PEER APPROVED 7/28/94  
CHAIRMAN *Stan Huber*

The selected location is accepted by me and is generally accepted by professional surveyors as the best available evidence of the position of the original corner.

**C. Description of monument for corner and accessories established to perpetuate locating the position of the corner:**

- G-13 Standard Kent County Monument
- Nail & K.C. remon. tag E side 38" Sycamore N 30° E 59.09'
- Nail & K.C. remon. tag S side 8" Elm S 50° E 44.27'
- Nail & K.C. remon. tag S side 4" Elm N 70° E 46.94'
- SE leg of C.P. tower (at ground) S 25° W 131.08'
- NW leg of C.P. tower (at ground) S 55° W 128.28'

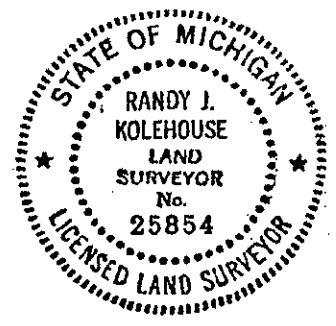

Signed by Randy J. Kolehouse  
Surveyor's Michigan License No. 25854

Date 11/21/94