

SURVEY & REMONUMENTATION

APR 28 1995

STATE OF MICHIGAN
COUNTY OF KENT
RECEIVED FOR RECORD

94 DEC -6 AM 8:58

For corners in **COMMISSION**

LAND CORNER RECORDATION CERTIFICATE Filing Requirement of Act 74, Mich. P.A. 1970 KENT COUNTY REMONUMENTATION

W. J. Bond
REG. OF DEEDS

Kent (County)	Located in:	Corner Code #
1. Public Land Survey	T <u>6N</u> R <u>12W</u>	<u>H-2</u>
	T _____ R _____	_____
	T _____ R _____	_____
	T _____ R _____	_____
2. Property Controlling in Section	S _____ T _____ R _____	_____
	S _____ T _____ R _____	_____
3. Miscellaneous Property in Sec.	S _____ T _____ R _____	_____
	S _____ T _____ R _____	_____

7739

Register of Deeds Stamp & File Number

4. Lot No. _____, Recorded Plat _____
5. Private Claims _____

	A	B	C	D	E	F	G	H	I	J	K	L	M
2	6	5	4					3	2	1			
3													
4	7	8	9	10	11	12							
5													
6	18	17	16	15	14	13							
7													
8	19	20	21	22	23	24							
9													
10	30	29	28	27	26	25							
11													
12	31	32	33	34	35	36							

I, Randy Kolehouse, in a field survey on October 10 19 94, do hereby certify that under requirements of P.A. 74 Michigan P.A. of 1970, the corner points mentioned in lines 1 and 2 above were in conformance with regulations and rules therefore as required in the current manual of survey instructions of the United States Department of the Interior, Bureau of Land Management or by a decree of a Court of Law and/or that the corner points mentioned in lines 3, 4 and 5 above were in conformance with the rules of the Michigan Board of Land Surveyors or by a Decree of a Court of Law; established, re-established, monumented, re-monumented, recovered, found as expressed below:

NOTE: Not more than 4 corners, all in the same town and range, may be recorded on this certificate.

A. Description of original monument and accessories and/or subsequent restoration:

H-2 This corner was not originally set by the G.L.O.

1902 Survey Records Williams & Works Fence Corner

This is the only reference to this corner. The Center of Section falls in C&O Railroad right-of-way.

B. Description of corner evidence found and/or method applied in restoring or reestablishing corner:


H-2 Set point for Center of Section 3 at the intersection of the E-W 1/4 line and the N-S 1/4 line using mid-point on north line Section between NE and NW corners of Section (this point falls in the Grand River and was not set by the G.L.O.).

P.A. 345 1990 KENT COUNTY
PEER APPROVED 10/12/94
CHAIRMAN *Harry Ruben*

C. Description of monument for corner and accessories established to perpetuate locating the position of the corner:

H-2 Unable to set Standard Kent County Monument. Set 60^d nail and EARTH TECH Cap in a railroad tie.

- Nail & K.C. remon. tag in S side p. pole S 50° E 131.02'
- Nail & K.C. remon. tag in W side p. pole South 45.52'
- Nail & K.C. remon. tag in W side p. pole S 77° W 149.11'
- P.K. nail in R.R. tie N 76° W 44.63'

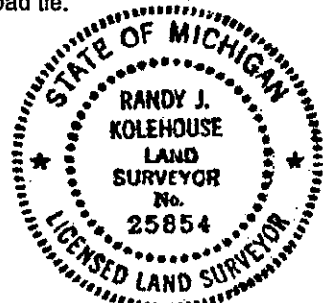

Signed by *Randy J. Kolehouse* Date 12/1/94
Surveyor's Michigan License No. 25854