

SURVEY & REMONUMENTATION

APR 28 1995

LAND CORNER RECORDATION CERTIFICATE Filing Requirement of Act 74, Mich. P.A. 1970 KENT COUNTY REMONUMENTATION

STATE OF MICHIGAN
COUNTY OF KENT
RECEIVED FOR RECORD

94 DEC -6 AM 8:58

For corners in COMMISSION
Kent
(County)

Located in:	Corner Code #
T <u>6N</u> R <u>12W</u>	<u>H-4</u>
T _____ R _____	_____
T _____ R _____	_____
T _____ R _____	_____
S _____ T _____ R _____	_____
S _____ T _____ R _____	_____
S _____ T _____ R _____	_____

W. J. Bond
REG. OF DEEDS

7742

Register of Deeds Stamp & File Number

- Public Land Survey
- Property Controlling in Section
- Miscellaneous Property in Sec.
- Lot No. _____, Recorded Plat _____
- Private Claims _____

	A	B	C	D	E	F	G	H	I	J	K	L	M
2	6	5	4	3	2	1							
3													
4	7	8	9	10	11	12							
5													
6	18	17	16	15	14	13							
7													
8	19	20	21	22	23	24							
9													
10	30	29	28	27	26	25							
11													
12	31	32	33	34	35	36							

I, Randy Kolehouse, in a field survey on April 27 19 94, do hereby certify that under requirements of P.A. 74 Michigan P.A. of 1970, the corner points mentioned in lines 1 and 2 above were in conformance with regulations and rules therefore as required in the current manual of survey instructions of the United States Department of the interior, Bureau of Land Management or by a decree of a Court of Law and/or that the corner points mentioned in lines 3, 4 and 5 above were in conformance with the rules of the Michigan Board of Land Surveyors or by a Decree of a Court of Law; established, re-established, monumented, re-monumented, recovered, found as expressed below:

NOTE: Not more than 4 corners, all in the same town and range, may be recorded on this certificate.

A. Description of original monument and accessories and/or subsequent restoration:

H-4	This corner was not originally set by the G.L.O.
1905	Survey Records Williams & Works Iron
1941	Survey Records Williams & Works "+" in Pavement
1941-1972	Survey Records Williams & Works "+" in Pavement
1972	L.C.R.C. #397 Williams & Works Iron
1984	L.C.R.C. #4046 William Byl Reset P.K. per #397

B. Description of corner evidence found and/or method applied in restoring or reestablishing corner:


H-4 Found P.K. and tag as set in L.C.R.C. #4046 in the C/L of Porter Avenue E-W. This point checks survey records of Williams & Works from 1905-1972 and L.C.R.C. #397. Said P.K. is 0.2' North and 5.6' West of the intersection of 1/4 lines. Accepted P.K. and tag as Center Section.

P.A. 345 1980 KENT COUNTY
PEER APPROVED 9/22/94
CHAIRMAN Harrison Huber

C. Description of monument for corner and accessories established to perpetuate locating the position of the corner:

H-4 Replaced P.K. and Tag with a Standard 4" x 30" Kent County Monument (Harrison).

- Nail & K.C. remon. tag in W side 18" Maple N 25° W 62.96'
- SW corner house #1951 N 15° E 46.20'
- SE corner conc. block porch hse. #1951 N 40° E 50.97'
- NW corner bottom concrete step bldg. #1950 S 45° E 88.30'
- NE corner brick veneer bldg. #2010 S 50° W 99.74'

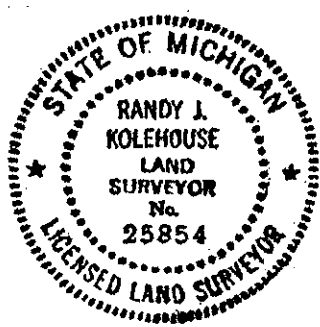

Signed by Randy J. Kolehouse Date 12/1/94
Surveyor's Michigan License No. 25854