

SURVEY & REMONUMENTATION

APR 28 1995

LAND CORNER RECORDATION CERTIFICATE Filing Requirement of Act 74, Mich. P.A. 1970 KENT COUNTY REMONUMENTATION

STATE OF MICHIGAN
COUNTY OF KENT
RECEIVED FOR RECORD

94 DEC -6 AM 8:58

For corners in **COMMISSION**

For corners in	Kent <small>(County)</small>	Located in:	Corner Code #
1. Public Land Survey		T <u>6N</u> R <u>12W</u>	<u>H-6</u>
		T _____ R _____	_____
		T _____ R _____	_____
		T _____ R _____	_____
2. Property Controlling in Section	S _____	T _____ R _____	_____
	S _____	T _____ R _____	_____
3. Miscellaneous Property in Sec.	S _____	T _____ R _____	_____
	S _____	T _____ R _____	_____

Levi J. Bond
REG. OF DEEDS

7740

Register of Deeds Stamp & File Number

4. Lot No. _____, Recorded Plat _____
5. Private Claims _____

	A	B	C	D	E	F	G	H	I	J	K	L	M
2	0	1	2	3	4	5	6	7	8	9	10	11	12
3													
4	7	8	9	10	11	12	13	14	15	16	17	18	19
5													
6	18	17	16	15	14	13	12	11	10	9	8	7	6
7													
8	19	20	21	22	23	24	25	26	27	28	29	30	31
9													
10	30	29	28	27	26	25	24	23	22	21	20	19	18
11													
12	31	32	33	34	35	36	37	38	39	40	41	42	43
13													

I, Randy Kolehouse, in a field survey on August 22 19 94, do hereby certify that under requirements of P.A. 74 Michigan P.A. of 1970, the corner points mentioned in lines 1 and 2 above were in conformance with regulations and rules therefore as required in the current manual of survey instructions of the United States Department of the Interior, Bureau of Land Management or by a decree of a Court of Law and/or that the corner points mentioned in lines 3, 4 and 5 above were in conformance with the rules of the Michigan Board of Land Surveyors or by a Decree of a Court of Law; established, re-established, monumented, re-monumented, recovered, found as expressed below:

NOTE: Not more than 4 corners, all in the same town and range, may be recorded on this certificate.

A. Description of original monument and accessories and/or subsequent restoration:

H-6 This corner was not originally set by the G.L.O.

1928	Survey Records	Williams & Works	Iron at Fence Corner
1928-1970	Survey Records	Williams & Works	Used Same Iron
1970	Survey Records	Williams & Works	Computes Iron to be 16.5' + S and 7' W of True Center
1973	L.C.R.C. #567	Medema Vankooten	1" Iron

B. Description of corner evidence found and/or method applied in restoring or reestablishing corner:

H-6 Found 1" iron pipe which checks survey records of Williams & Works 1928-1970. This corner has been used continually since 1928 for all land subdivision. Iron is 17.4' South and 7.2' West of intersection of 1/4 lines. Accepted 1" iron as Center Section.

P.A. 345 1990 KENT COUNTY


PEER APPROVED 9/22/94

CHAIRMAN *[Signature]*

C. Description of monument for corner and accessories established to perpetuate locating the position of the corner:

H-6 Replaced 1" iron with Standard 4" x 30" K.C. Monument.

- Nail & K.C. remon. tag in N side 18" Oak N 80° E 33.14'
- Nail & K.C. remon. tag in W side 28" Oak N 10° E 41.15'
- Nail & K.C. remon. tag in SE side 24" Oak N 40° E 44.69'
- Nail & K.C. remon. tag in N side 30" Pine S 50° W 33.21'
- Nail in W side 28" Oak S 15° W 11.36'

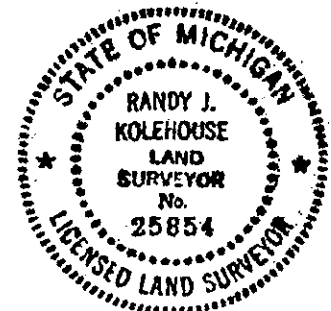

Signed by Randy J. Kolehouse
Surveyor's Michigan License No. 25854

Date 12/1/94