

SURVEY & REMONUMENTATION

APR 28 1995

LAND CORNER RECORDATION CERTIFICATE Filing Requirement of Act 74, Mich. P.A. 1970 KENT COUNTY REMONUMENTATION

STATE OF MICHIGAN
COUNTY OF KENT
RECEIVED FOR RECORD

94 DEC -6 AM 8:58

For corners in

Kent COMMISSION located in:

Corner Code #

1. Public Land Survey	T <u>6N</u>	R <u>12W</u>	<u>H-8</u>
	T _____	R _____	_____
	T _____	R _____	_____
	T _____	R _____	_____
2. Property Controlling in Section	S _____	T _____	R _____
	S _____	T _____	R _____
3. Miscellaneous Property in Sec.	S _____	T _____	R _____
	S _____	T _____	R _____

W. J. Floyd
REG. OF DEEDS

7741

Register of Deeds Stamp & File Number

4. Lot No. _____, Recorded Plat _____
5. Private Claims _____

Randy Kolehouse, in a field survey on November 3 19 94,
I hereby certify that under requirements of P.A. 74 Michigan P.A. of 1970, the corner points mentioned in lines 1 and 2 above were in conformance with regulations and rules therefore as required in the current manual of survey instructions of the United States Department of the Interior, Bureau of Land Management or by a decree of a Court of Law and/or that the corner points mentioned in lines 3, 4 and 5 above were in conformance with the rules of the Michigan Board of Land Surveyors or by a Decree of a Court of Law; established, re-established, monumented, re-monumented, recovered, found as expressed below:

	A	B	C	D	E	F	G	H	I	J	K	L	M
2	6	5	4	3	2								
3													
4	7	8	9	10	11	12							
5													
6	18	17	16	15	14	13							
7													
8	19	20	21	22	23	24							
9													
10	30	29	28	27	26	25							
11													
12	31	32	33	34	35	36							
13													

NOTE: Not more than 4 corners, all in the same town and range, may be recorded on this certificate.

Description of original monument and accessories and/or subsequent restoration:

-8 This corner was not originally set by the G.L.O.

1957	Survey Notes	Williams & Works	Conc. Plat Mon.
N/A	Survey Notes	Exxel Engineering	Conc. Plat Mon.

Description of corner evidence found and/or method applied in restoring or reestablishing corner:

-8 Found conc. plat monument at the SE corner of Broad Acres L. 37 P. 30 per survey records of Williams & Works. The monument is 0.7' South and 4.7' West of the intersection of 1/4 lines which checks Exxel Engineering records (0.6' N and 4.6' W). Accepted as Center Section.

P.A. 345 1990 KENT COUNTY


PEER APPROVED 12/22/94

CHAIRMAN *Harry Fisher*

Description of monument for corner and accessories established to perpetuate locating the position of the corner:

-8 Placed a K.C. Cap on Conc. Plat Mon.

- P.K. Nail & K.C. remon. tag in E side 16" Oak North 2.21'
- P.K. Nail & K.C. remon. tag in SE side 10" Cedar S 20° W 3.18'
- P.K. Nail & K.C. remon. tag in N side 4" x 4" wood post S 80° W 2.26'
- NE corner fr. hse. (1955 Floyd) S 40° E 69.34'
- NE corner fr. hse. (1955 Floyd) S 20° W 51.00'

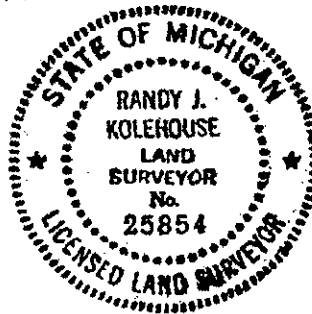

Surveyed by Randy J. Kolehouse
Surveyor's Michigan License No. 25854

Date 12/1/94