

**SURVEY & REMONUMENTATION**

Kent County Remonumentation

STATE OF MICHIGAN  
COUNTY OF KENT  
RECEIVED FOR RECORD

APR 28 1995

LAND CORNER RECORDATION CERTIFICATE  
Filing Requirement of Act 74, Mich. P.A. 1970

94 NOV 29 AM 9:22

For corners in Kent **COMMISSION**

(County)	Located In:	Corner Code =#
1. Public Land Survey	T 6N R 12W	H-9
	T _____ R _____	_____
	T _____ R _____	_____
	T _____ R _____	_____
2. Property Controlling in Section	S _____ T _____ R _____	_____
	S _____ T _____ R _____	_____
3. Miscellaneous Property in Sec.	S _____ T _____ R _____	_____
	S _____ T _____ R _____	_____

*W. J. Bond*  
REG. OF DEEDS

7460

Register of Deeds Stamp & File Number

4. Lot No. \_\_\_\_\_, Recorded Plat \_\_\_\_\_  
5. Private Claims \_\_\_\_\_

	A	B	C	D	E	F	G	H	I	J	K	L	M
2	6		5		4		3		2		1		
3													
4	7		8		9		10		11		12		
5													
6	18		17		16		15		14		13		
7													
8	19		20		21		22		23		24		
9													
10	30		29		28		27		26		25		
11													
12	31		32		33		34		35		36		
13													

I, Randy Kolehouse, in a field survey on May 17, 19 94, do hereby certify that under requirements of P.A. 74, Michigan P.A. of 1970, the corner points mentioned in lines 1 and 2 above were in conformance with regulations and rules therefore as required in the current manual of survey instructions of the United States Department of the Interior, Bureau of Land Management or by a decree of a Court of Law and/or that the corner points mentioned in lines 3, 4 and 5 above were in conformance with the rules of the Michigan Board of Land Surveyors or by a Decree of a Court of Law, established, re-established, monumented, re-monumented, recovered, found as expressed below:

**NOTE: Not more than 4 corners, all in the same town and range, may be recorded on this certificate.**

**A. Description of original monument and accessories and/or subsequent restoration:**

H-9	1831	G.L.O. Notes	L. Lyon	Set Post
	1939	Wit. Map	K.C. Surveyor	Concrete Monument
	1957	Wit. Map	K.C. Surveyor	Concrete Monument
	N/A	Survey Records	Exxel Engineering	N/A
	1981	L.C.R.C. #2343	Exxel Engineering	Set K.C. Monument
	1988	L.C.R.C. #4682	Bueche	K.C. Monument

P.A. 345 1990 KENT COUNTY

PEER APPROVED 7/28/94  
CHAIRMAN Harry Huber

The position of this corner was previously approved by the Kent County Remonumentation Peer Group and monumented by Exxel Engineering, Inc., on 12/1/81 and was recorded per L.C.R.C. #2343.

**B. Description of corner evidence found and/or method applied in restoring or reestablishing corner:**

H-9 Found K.C. Monument 6' M/L North of the C/L of Eastbound 44th Street per L.C.R.C.'s #2343 and #4682 which was set by Exxel Engineering using survey records from Exxel Engineering.

**L.C.R.C. #2343**

- Spike & K.C. remon. tag in W side 42" Oak S 5° E 52.38'
- Spike & K.C. remon. tag in NE side 26" Oak S 45° E 92.45'
- Spike & K.C. remon. tag (5' high) NW side 18" Oak N 45° E 136.52'
- Spike & K.C. remon. tag in SW side 30" Oak N 70° W 211.24'
- C/L of sewer M.H. cover N 85° W 19.96'
- NW cor. garage fndn. S 50° W 99.37'

**L.C.R.C. #4682**


- Spike & K.C. remon. tag in W side 42" Oak S 5° E 52.38'
- Spike & K.C. remon. tag in NE side 26" Oak S 45° E 92.45'
- Spike & K.C. remon. tag (5' high) NW side 18" Oak N 45° E 136.52'
- Spike & K.C. remon. tag in SW side 30" Oak N 70° W 211.24'
- C/L of sewer M.H. cover N 85° W 19.96'
- NW cor. garage fndn. S 50° W 99.37'

The selected location is accepted by me and is generally accepted by professional surveyors as the best available evidence of the position of the original corner.

**C. Description of monument for corner and accessories established to perpetuate locating the position of the corner:**

H-9 Standard Kent County Monument

- Spike & K.C. remon. tag in W side 42" Oak S 5° E 52.38'
- Spike & K.C. remon. tag in NE side 26" Oak S 45° E 92.45'
- Spike & K.C. remon. tag (5' high) NW side 18" Oak N 45° E 136.52'
- Spike & K.C. remon. tag in SW side 30" Oak N 70° W 211.24'
- C/L of sewer M.H. cover N 85° W 19.96'
- NW cor. garage fndn. S 50° W 99.37'

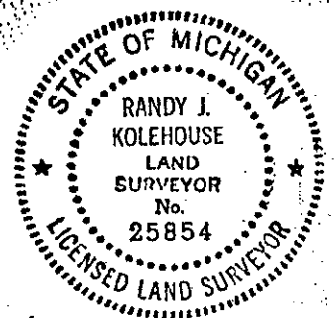

Signed by Randy J. Kolehouse  
Surveyor's Michigan License No. 25854

Date 11/21/94