

SURVEY & REMONUMENTATION

Kent County Remonumentation

STATE OF MICHIGAN
COUNTY OF KENT
RECEIVED FOR RECORD

APR 28 1995

LAND CORNER RECORDATION CERTIFICATE
Filing Requirement of Act 74, Mich. P.A. 1970

94 NOV 29 AM 9:22

For corners in Kent **COMMISSION**

(County)	Located In:	Corner Code #
1. Public Land Survey	T <u>6N</u> R <u>12W</u>	<u>H-11</u>
	T _____ R _____	_____
	T _____ R _____	_____
	T _____ R _____	_____
2. Property Controlling in Section	S _____ T _____ R _____	_____
	S _____ T _____ R _____	_____
3. Miscellaneous Property in Sec.	S _____ T _____ R _____	_____
	S _____ T _____ R _____	_____


W. J. K.
REG. OF DEEDS

7461

Register of Deeds Stamp & File Number

4. Lot No. _____, Recorded Plat _____
5. Private Claims _____

I, Randy Kolehouse, in a field survey on March 24, 19 94, do hereby certify that under requirements of P.A. 74, Michigan P.A. of 1970, the corner points mentioned in lines 1 and 2 above were in conformance with regulations and rules therefore as required in the current manual of survey instructions of the United States Department of the Interior, Bureau of Land Management or by a decree of a Court of Law and/or that the corner points mentioned in lines 3, 4 and 5 above were in conformance with the rules of the Michigan Board of Land Surveyors or by a Decree of a Court of Law; established, re-established, monumented, re-monumented, recovered, found as expressed below:

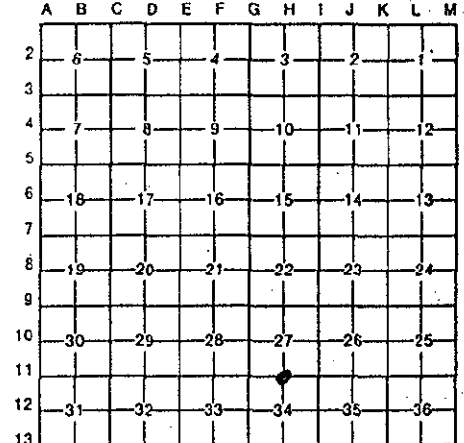

NOTE: Not more than 4 corners, all in the same town and range, may be recorded on this certificate.

A. Description of original monument and accessories and/or subsequent restoration:

H-11	1831	G.L.O. Notes	L. Lyon	Set Post
	1940	Wit Map	KC Surveyor	Stone & Iron
	1971	L.C.R.C. #54	Williams & Works	"T" Iron
	1980	L.C.R.C. #1460	Williams & Works	Fnd. "T" Iron/Set K.C. Mon.
	1989	L.C.R.C. #4683	Bueche	Set KC Mon.

P.A. 345 1990 KENT COUNTY
PEER APPROVED 7/28/94
CHAIRMAN Randy Kolehouse

This corner was originally approved by the Kent County Remonumentation Peer Group and monumented by Williams & Works, Inc., on 2/4/81 and was recorded per L.C.R.C. #1460

B. Description of corner evidence found and/or method applied in restoring or reestablishing corner:

H-11 Found K.C. Monument 4' M/L S of centerline 52nd Street running E-W per L.C.R.C. #1460 and #4683, as set by Williams & Works in place of a "T" iron over (2) 3/4" irons which they found and checked with 1940 Wit Map and L.C.R.C. #54.


L.C.R.C. #1460
Nail & K.C. remon. tag in SW side L & T pole N 45° W 56.89'
New nail & K.C. remon tag in E side tri. 10" Elm N 10 E 50.25'
Nail & K.C. remon. tag in N side 22" Walnut S 65° E 64.38'
SW cor. frame hse. S 40° E 141.31'
Nail & K.C. remon. tag in NW side p. & TV pole S 50° W 59.18'
NE cor. conc. porch at NE cor. hse. S 70° W 116.77'

L.C.R.C. #4683

The selected location is accepted by me and is generally accepted by professional surveyors as the best available evidence of the position of the original corner.

C. Description of monument for corner and accessories established to perpetuate locating the position of the corner:

H-11 Standard Kent County Monument
Nail & K.C. remon. tag in SW side L & T pole N 45° W 56.89'
New nail & K.C. remon tag in E side tri. 10" Elm N 10 E 50.25'
Nail & K.C. remon. tag in N side 22" Walnut S 65° E 64.38'
SW cor. frame hse. S 40° E 141.31'
Nail & K.C. remon. tag in NW side p. & TV pole S 50° W 59.18'
NE cor. conc. porch at NE cor. hse. S 70° W 116.77'

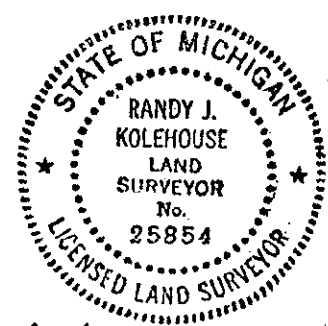

Signed by Randy J. Kolehouse
Surveyor's Michigan License No. 25854

Date 11/21/94