

**SURVEY &
REMONUMENTATION**

APR 28 1995

LAND CORNER RECORDATION CERTIFICATE
Filing Requirement of Act 74, Mich. P.A. 1970
KENT COUNTY REMONUMENTATION

STATE OF MICHIGAN
COUNTY OF KENT
RECEIVED FOR RECORD

94 DEC -6 AM 8:58

For corners in

COMMISSION

Kent
(County)

Located in:

Corner Code #

- | | | | |
|------------------------------------|-------------|--------------|-------------|
| 1. Public Land Survey | T <u>6N</u> | R <u>12W</u> | <u>H-12</u> |
| | T _____ | R _____ | _____ |
| | T _____ | R _____ | _____ |
| | T _____ | R _____ | _____ |
| 2. Property Controlling in Section | S _____ | T _____ | R _____ |
| | S _____ | T _____ | R _____ |
| 3. Miscellaneous Property in Sec. | S _____ | T _____ | R _____ |
| | S _____ | T _____ | R _____ |

W. J. Bond
REG. OF DEEDS

7744

Register of Deeds Stamp & File Number

4. Lot No. _____, Recorded Plat _____
5. Private Claims _____

I, Randy Kolehouse, in a field survey on October 8 19 94, do hereby certify that under requirements of P.A. 74 Michigan P.A. of 1970, the corner points mentioned in lines 1 and 2 above were in conformance with regulations and rules therefore as required in the current manual of survey instructions of the United States Department of the Interior, Bureau of Land Management or by a decree of a Court of Law and/or that the corner points mentioned in lines 3, 4 and 5 above were in conformance with the rules of the Michigan Board of Land Surveyors or by a Decree of a Court of Law; established, re-established, monumented, re-monumented, recovered, found as expressed below:

NOTE: Not more than 4 corners, all in the same town and range, may be recorded on this certificate.

	A	B	C	D	E	F	G	H	I	J	K	L	M
2	6	5	4	3	2	1							
3													
4	7	8	9	10	11	12							
5													
6	18	17	16	15	14	13							
7													
8	19	20	21	22	23	24							
9													
10	30	29	28	27	26	25							
11													
12	31	32	33	34	35	36							
13													

A. Description of original monument and accessories and/or subsequent restoration:

H-12 This corner was not originally set by the G.L.O.

1905	Survey Records	Williams & Works	Stake
1928	Survey Records	Williams & Works	Fnd. Iron at Loc. of Stake
1941	Survey Records	Williams & Works	Iron
1948-1973	Survey Records	Williams & Works	Iron
1987-1988	Survey Records	Rob Jonker	Iron

B. Description of corner evidence found and/or method applied in restoring or reestablishing corner:


H-12 Iron as shown in Williams & Works and Jonker surveys has been destroyed due to construction. Reset point using survey records of Jonker Land Surveys. This point checks on remaining wit. from Jonker Land Surveys. Also checks dist. to South 1/4 corner shown in 1905 Williams & Works survey and distance to West 1/4 shown in 1946 Williams & Works survey as well as one wit. Point is 0.5' South and 3.5' West of intersection of 1/4 lines. Accepted point for Center Section.

P.A. 345 1990 KENT COUNTY
PEER APPROVED 9/22/94
CHAIRMAN Harry Hubert

C. Description of monument for corner and accessories established to perpetuate locating the position of the corner:

H-12 Set Standard 4" x 30" Kent County Monument (Harrison).

- Nail & K.C. remon. tag in NE side 15" Oak S 50° E 74.18'
- Nail & K.C. remon. tag in NW side 12" Oak S 55° W 49.97'
- Nail & K.C. remon. tag in NE side p. pole N 45° W 10.91'
- Nail & K.C. remon. tag in N side fence post N 85° W 43.88'

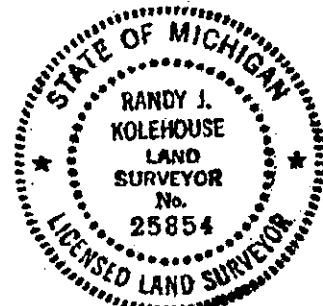

Signed by Randy J. Kolehouse
Surveyor's Michigan License No. 25854

Date 12/1/94