SURVEY & REMONUMENTATION

APR 28 1995

COMMISSION

Kent County Remonumentation

STATE OF MICHIGAN
COUNTY OF KENT
RECEIVED FOR RECORD
94 NOV 29 AM 9:22

REG. OF DEEDS

LAND CORNER RECORDATION CERTIFICATE

Filing Requirement of Act 74, Mich. P.A. 1970

For corners in Kent (County)

	Located In:	Corner Code ##
1. Public Land Survey	T 6N R 12W	H-13
	T ___ R ___	
	T ___ R ___	
	T ___ R ___	
2. Property Controlling	S ___ T ___ R ___	
in Section	S ___ T ___ R ___	
3. Miscellaneous	S ___ T ___ R ___	
Property in Sec.	S ___ T ___ R ___	

7462

Register of Deeds Stamp & File Number

4. Lot No. _____, Recorded Plat _____
5. Private Claims _____

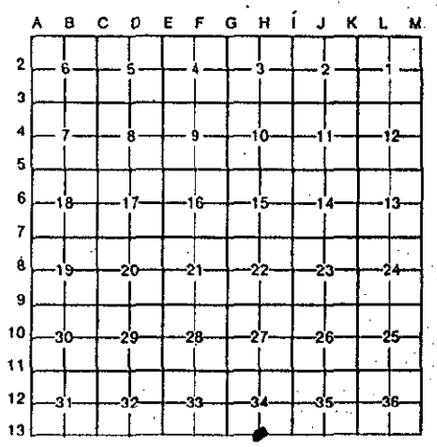

I, Randy Kolehouse, in a field survey on June 20, 19 94, do hereby certify that under requirements of P.A. 74, Michigan P.A. of 1970, the corner points mentioned in lines 1 and 2 above were in conformance with regulations and rules therefore as required in the current manual of survey instructions of the United States Department of the Interior, Bureau of Land Management or by a decree of a Court of Law and/or that the corner points mentioned in lines 3, 4 and 5 above were in conformance with the rules of the Michigan Board of Land Surveyors or by a Decree of a Court of Law: established, re-established, monumented, re-monumented, recovered, found as expressed below:

NOTE: Not more than 4 corners, all in the same town and range, may be recorded on this certificate.

A. Description of original monument and accessories and/or subsequent restoration:

H-13	1831	G.L.O. Notes	L. Lyon	Set Post
	NA	Wit Map	KC Surveyor	Leaded Stones
	1983	L.C.R.C. #3663	Exxel	Fnd 3/4" Iron/Set K.C. Mon
	1988	L.C.R.C. #4684	Bueche	K.C. Mon

P.A. 345 1990 KENT COUNTY
PEER APPROVED 9/22/94
CHAIRMAN Larry Stuber

The position of this corner was previously approved by the Kent County Remonumentation Peer Group monumented by Exxel Engineering on 8/24/83 and was recorded per L.C.R.C. #3663.

B. Description of corner evidence found and/or method applied in restoring or reestablishing corner:

H-13 Found KC Monument per L.C.R.C. #3663 & #4684 as set by Exxel Eng. in place of a 3/4" iron at fence corner which checks Williams & Works survey records back to 1935 as being 6.67' East of the N 1/4 Section 3 T5N R12W.

L.C.R.C. #3663	L.C.R.C. #4684
Set remon. tag in S'ly side 18" Ash N 84° W 53.36'	Remon. tag & nail in W'ly side 13" Ash N 84° W 53.36'
Set remon. tag in SW'ly side 22" Beech N 46° W 65.74'	Remon. tag & nail in SW'ly side 22" Beech N 46° W 65.74'
K.C. Standard Mon. H-1 West 6.67'	K.C. Standard Mon. H-1 N 1/4, Sec. 3, 5, 12 W 6.67'

The selected location is accepted by me and is generally accepted by professional surveyors as the best available evidence of the position of the original corner.

C. Description of monument for corner and accessories established to perpetuate locating the position of the corner:

H-13 Standard Kent County Monument
Nail & K.C. remon. tag in W'ly side 13" Ash N 84° W 53.36'
Nail & K.C. remon. tag in SW'ly side 22" Beech N 46° W 65.74'
Nail & K.C. remon. tag in SW sde 6" Ash S 55° E 6.53'
Nail & K.C. remon. tag in NW side 8" Maple S 35° W 54.20'
K.C. Standard Mon. H-1 N 1/4, Sec. 3, T5N, R12W, West 6.67"

STATE OF MICHIGAN
RANDY J. KOLEHOUSE
LAND SURVEYOR
No. 25854
LICENSED LAND SURVEYOR

Signed by Randy J Kolehouse Date 11/21/94

Surveyor's Michigan License No. 25854

FORM APPROVED BY MICHIGAN STATE BOARD OF LAND SURVEYORS, JAN. 28, 1971
REVISED MAY 14, 1975
REVISED JAN., 1983