

**SURVEY & REMONUMENTATION**

Kent County Remonumentation

STATE OF MICHIGAN  
COUNTY OF KENT  
RECEIVED FOR RECORD

APR 28 1995

**LAND CORNER RECORDATION CERTIFICATE**  
Filing Requirement of Act 74, Mich. P.A. 1970

94 NOV 29 AM 9:22

For corners in **COMMISSION**  
Kent

*W. J. Bond*  
REG. OF DEEDS

(County)	Located In:	Corner Code -#
1. Public Land Survey	T <u>6N</u> R <u>12W</u>	<u>I-1</u>
	T _____ R _____	_____
	T _____ R _____	_____
	T _____ R _____	_____
2. Property Controlling in Section	S _____ T _____ R _____	_____
	S _____ T _____ R _____	_____
3. Miscellaneous Property in Sec.	S _____ T _____ R _____	_____
	S _____ T _____ R _____	_____

**7463**

Register of Deeds Stamp & File Number

4. Lot No. \_\_\_\_\_, Recorded Plat \_\_\_\_\_  
5. Private Claims \_\_\_\_\_

	A	B	C	D	E	F	G	H	I	J	K	L	M
2	6	5	4	3	2	1							
3													
4	7	8	9	10	11	12							
5													
6	13	17	16	15	14	13							
7													
8	19	20	21	22	23	24							
9													
10	30	29	28	27	26	25							
11													
12	31	32	33	34	35	36							
13													

I, Randy Kolehouse, in a field survey on April 22, 19 94, do hereby certify that under requirements of P.A. 74, Michigan P.A. of 1970, the corner points mentioned in lines 1 and 2 above were in conformance with regulations and rules therefore as required in the current manual of survey instructions of the United States Department of the Interior, Bureau of Land Management or by a decree of a Court of Law and/or that the corner points mentioned in lines 3, 4 and 5 above were in conformance with the rules of the Michigan Board of Land Surveyors or by a Decree of a Court of Law; established, re-established, monumented, re-monumented, recovered, found as expressed below:

**NOTE: Not more than 4 corners, all in the same town and range, may be recorded on this certificate.**

**A. Description of original monument and accessories and/or subsequent restoration:**

I-1	1831	G.L.O. Notes	L. Lyon	Set Post
	1893-94	Survey Notes	City of Grand Rapids	N/A
	1984	L.C.R.C. #4124	William Byl	Set K.C. Monument

P.A. 345 1990 KENT COUNTY  
PEER APPROVED 9/22/94  
CHAIRMAN *Henry Huber*

The position of this corner was previously approved by the Kent County Remonumentation Peer Group monumented by William R. Byl on 11/30/84 and was recorded per L.C.R.C. #4124.

**B. Description of corner evidence found and/or method applied in restoring or reestablishing corner:**

I-1 Found K.C. Monument per L.C.R.C. #4124 as set by William Byl using survey records from the City of Grand Rapids & Williams & Works (1893-1894).


L.C.R.C. #4124

Nail & tag in W side MBT pole #6585 N 40° W 7.82'

The selected location is accepted by me and is generally accepted by professional surveyors as the best available evidence of the position of the original corner.

**C. Description of monument for corner and accessories established to perpetuate locating the position of the corner:**

- I-1 Standard Kent County Monument
  - Nail & K.C. remon. tag 3' high NW side power pole S 50° W 22.69'
  - NW cor. conc. pad S 80° E 106.83'
  - Nail & K.C. remon. tag in NE side MBT pole N 40° W 7.95'
  - SE cor. conc. block bldg. N 05° E 107.42'

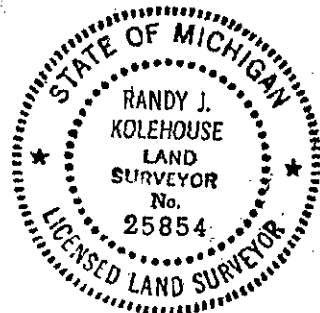

Signed by *Randy J. Kolehouse*  
Surveyor's Michigan License No. 25854

Date 11/21/94