

**SURVEY & REMONUMENTATION**

Kent County Remonumentation

STATE OF MICHIGAN  
COUNTY OF KENT  
RECEIVED FOR RECORD

APR 28 1995

LAND CORNER RECORDATION CERTIFICATE 94 NOV 29 AM 9:22  
Filing Requirement of Act 74, Mich. P.A. 1970

**COMMISSION**


For corners in Kent

*W. J. Colehouse*  
REG. OF DEEDS

(County)	Located In:	Corner Code #
1. Public Land Survey	T 6N R 12W	1-2
	T ___ R ___	_____
	T ___ R ___	_____
	T ___ R ___	_____
2. Property Controlling in Section	S ___ T ___ R ___	_____
	S ___ T ___ R ___	_____
3. Miscellaneous Property in Sec.	S ___ T ___ R ___	_____
	S ___ T ___ R ___	_____

**7464**  
Register of Deeds Stamp & File Number

4. Lot No. \_\_\_\_\_, Recorded Plat \_\_\_\_\_  
5. Private Claims \_\_\_\_\_

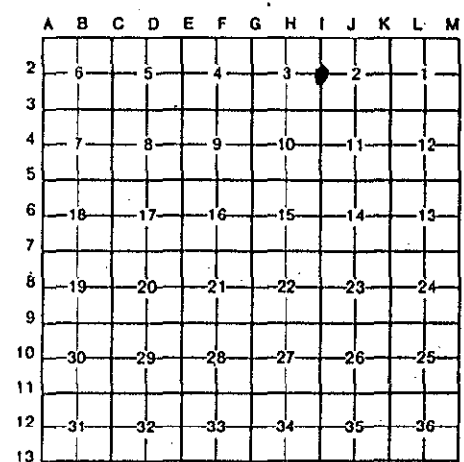

I, Randy Kolehouse, in a field survey on April 27, 19 94, do hereby certify that under requirements of P.A. 74, Michigan P.A. of 1970, the corner points mentioned in lines 1 and 2 above were in conformance with regulations and rules therefore as required in the current manual of survey instructions of the United States Department of the Interior, Bureau of Land Management or by a decree of a Court of Law and/or that the corner points mentioned in lines 3, 4 and 5 above were in conformance with the rules of the Michigan Board of Land Surveyors or by a Decree of a Court of Law; established, re-established, monumented, re-monumented, recovered, found as expressed below:

**NOTE: Not more than 4 corners, all in the same town and range, may be recorded on this certificate.**

A. Description of original monument and accessories and/or subsequent restoration:

I-2	1831	G.L.O. Notes	L. Lyon	Set Post
	1959	Wit. Map	K.C. Surveyor	Bt. Spike
	1977	L.C.R.C. #1019	MDSH	Set Iron in Mon. Box
	1980	L.C.R.C. #1462	Williams & Works	Fnd Iron in Mon. Box
	1983	L.C.R.C. #3204	Slater	K.C. Monument

P.A. 345 1990 KENT COUNTY  
PEER APPROVED 9/22/94  
CHAIRMAN [Signature]

The position of this corner was previously approved by the Kent County Remonumentation Peer Group monumented by Williams & Works on 10/29/80 and was recorded per L.C.R.C. #1462.

B. Description of corner evidence found and/or method applied in restoring or reestablishing corner:


I-2 Set point by wit. L.C.R.C.'s #1462 and #3204. This point was monumented by Williams & Works in place of a copper bar in monument box they wound which checked L.C.R.C. #1019 and K.C. surveyor's records.

L.C.R.C. #3204	L.C.R.C. #1462
Top center fire hyd. S 40° E 31.87'	Nail & tag in p. pole S 18° W 100.27'
Nail & cap in power pole S 18° W 100.27'	
NE cor. bldg. S 65° W 58.03'	
SE cor. bldg. S 55° W 69.20'	

The selected location is accepted by me and is generally accepted by professional surveyors as the best available evidence of the position of the original corner.

C. Description of monument for corner and accessories established to perpetuate localing the position of the corner:

I-2 Set Standard Kent County Monument  
Top center fire hyd. S 40° E 31.87'  
Nail & cap in power pole S 18° W 100.27'  
NE cor. bldg. S 65° W 58.03'  
SE cor. bldg. S 55° W 69.20'

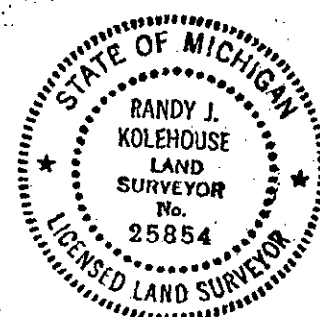

Signed by Randy J. Kolehouse  
Surveyor's Michigan License No. 25854

Date 11/21/94