

SURVEY & REMONUMENTATION

Kent County Remonumentation

STATE OF MICHIGAN
COUNTY OF KENT
RECEIVED FOR RECORD

APR 28 1995

LAND CORNER RECORDATION CERTIFICATE 94 NOV 29 AM 9:23
Filing Requirement of Act 74, Mich. P.A. 1970

For corners in **COMMISSION**
Kent

Tim J. Fisher
REG. OF DEEDS

(County)	Located In:	Corner Code =#
1. Public Land Survey	T <u>6N</u> R <u>12W</u>	<u>I-3</u>
	T _____ R _____	_____
	T _____ R _____	_____
	T _____ R _____	_____
2. Property Controlling in Section	S _____ T _____ R _____	_____
	S _____ T _____ R _____	_____
3. Miscellaneous Property in Sec.	S _____ T _____ R _____	_____
	S _____ T _____ R _____	_____

7465

Register of Deeds Stamp & File Number

4. Lot No. _____, Recorded Plat _____
5. Private Claims _____

	A	B	C	D	E	F	G	H	I	J	K	L	M
2	6	5	4	3	2	1							
3													
4	7	8	9	10	11	12							
5													
6	18	17	16	15	14	13							
7													
8	19	20	21	22	23	24							
9													
10	30	29	28	27	26	25							
11													
12	31	32	33	34	35	36							
13													

I, Randy Kolehouse, in a field survey on April 6, 1994,

do hereby certify that under requirements of P.A. 74, Michigan P.A. of 1970, the corner points mentioned in lines 1 and 2 above were in conformance with regulations and rules therefore as required in the current manual of survey instructions of the United States Department of the Interior, Bureau of Land Management or by a decree of a Court of Law and/or that the corner points mentioned in lines 3, 4 and 5 above were in conformance with the rules of the Michigan Board of Land Surveyors or by a Decree of a Court of Law; established, re-established, monumented, re-monumented, recovered, found as expressed below:

NOTE: Not more than 4 corners, all in the same town and range, may be recorded on this certificate.

A. Description of original monument and accessories and/or subsequent restoration:

I-3	1831	G.L.O. Notes	L. Lyon	Set Post
	1941	Wit. Map	K.C. Surveyor	Bt. Spike
	1958	Wit. Map	K.C. Surveyor	Iron
	1973	L.C.R.C. #494	Williams & Works	PK Nail
	1977	L.C.R.C. #1021	MDSH	Bt. Spike in Mon. Box
	1982	L.C.R.C. #2701	Jonker	Fnd. Bt. Spike In Mon. Box/Set K.C. Monument
	1988	L.C.R.C. #4685	Bueche	K.C. Monument

P.A. 345 1990 KENT COUNTY
PEER APPROVED 9/22/94
CHAIRMAN *Henry Fisher*

The position of this corner was previously approved by the Kent County Remonumentation Peer Group monumented by Jonker Land Surveys on 3/8/82 and was recorded per L.C.R.C. #270.

B. Description of corner evidence found and/or method applied in restoring or reestablishing corner:

I-3 Found K.C. Monument at Burton Street running E-W and Burlingame Avenue running N-S was set by Rob Jonker in place of a boat spike in monument box which he found which checks L.C.R.C.'s #494 and #1021 and also K.C. surveyor's records.


L.C.R.C. #2701
SE cor. hse. fndn. N 43° W 121.9'
Remon. tag N side p. pole S 70° W 76.11'
Remon. tag SW side p. pole N 47° W 51.05'
"X" chiseled on NE side steel pole S 40° E 63.01'
C/L M.H. N 85° E 30.43'
C/L M.H. S 00° E 49.92'
C/L M.H. N 10° E 42.0'

L.C.R.C. #4685
SE cor. hse. fndn. N 43° W 121.9'
Remon. tag N side p. pole S 70° W 76.11'
Remon. tag SW side p. pole N 47° W 51.05'
"X" chiseled on NE side steel pole S 40° E 63.01'
C/L M.H. N 85° E 30.43'
C/L M.H. S 00° E 49.92'
C/L M.H. N 10° E 42.00'

The selected location is accepted by me and is generally accepted by professional surveyors as the best available evidence of the position of the original corner.

C. Description of monument for corner and accessories established to perpetuate locating the position of the corner:

I-3 Standard Kent County Monument
SE cor. hse. fndn. N 43° W 121.9'
Nail & K.C. remon. tag N side p. pole S 70° W 76.11'
Nail & K.C. remon. tag SW side p. pole N 47° W 51.05'
"X" chiseled on NE side steel pole S 40° E 63.01'
C/L M.H. N 85° E 30.43'
C/L M.H. S 00° E 49.92'
C/L M.H. N 10° E 42.00'

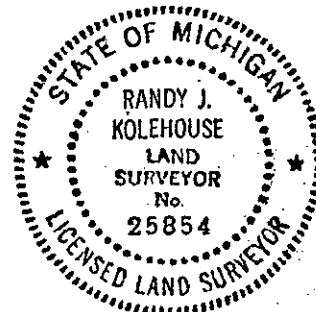

Signed by Randy J. Kolehouse Date 11/21/94
Surveyor's Michigan License No. 25854