

# SURVEY & REMONUMENTATION

APR 28 1995

Kent County Remonumentation

STATE OF MICHIGAN  
COUNTY OF KENT  
RECEIVED FOR RECORD

94 NOV 29 AM 9:23

## COMMISSION

### LAND CORNER RECORDATION CERTIFICATE Filing Requirement of Act 74, Mich. P.A. 1970

*W. J. K. Jones*  
REG. OF DEEDS

7466

Register of Deeds Stamp & File Number

For corners in  
Kent

(County)

Located In:

Corner Code ##

1. Public Land Survey	T <u>6N</u> R <u>12W</u>	<u>1-4</u>
	T _____ R _____	_____
	T _____ R _____	_____
	T _____ R _____	_____
2. Property Controlling in Section	S _____ T _____ R _____	_____
	S _____ T _____ R _____	_____
3. Miscellaneous Property in Sec.	S _____ T _____ R _____	_____
	S _____ T _____ R _____	_____

4. Lot No. \_\_\_\_\_, Recorded Plat \_\_\_\_\_

5. Private Claims \_\_\_\_\_

	A	B	C	D	E	F	G	H	I	J	K	L	M
2	6	5	4	3	2	1							
3													
4	7	8	9	10	11	12							
5													
6	18	17	16	15	14	13							
7													
8	19	20	21	22	23	24							
9													
10	30	29	28	27	26	25							
11													
12	31	32	33	34	35	36							
13													

I, Randy Kolehouse, in a field survey on April 6, 19 94,

do hereby certify that under requirements of P.A. 74, Michigan P.A. of 1970, the corner points mentioned in lines 1 and 2 above were in conformance with regulations and rules therefore as required in the current manual of survey instructions of the United States Department of the Interior, Bureau of Land Management or by a decree of a Court of Law and/or that the corner points mentioned in lines 3, 4 and 5 above were in conformance with the rules of the Michigan Board of Land Surveyors or by a Decree of a Court of Law; established, re-established, monumented, re-monumented, recovered, found as expressed below:

**NOTE: Not more than 4 corners, all in the same town and range, may be recorded on this certificate.**

A. Description of original monument and accessories and/or subsequent restoration:

1-4	1831	G.L.O. Notes	L. Lyon	Set Post	P.A. 345 1990 KENT COUNTY
	1940	Wit. Map	K.C. Surveyor	R.R. Iron	PEER APPROVED <u>8/11/94</u>
	1972	L.C.R.C. #397	Williams & Works	R.R. Iron	CHAIRMAN <u>Harry Huber</u>
	1975	L.C.R.C. #832	Moore & Bruggink	R.R. Spike	
	1982	L.C.R.C. #2705	Jonker	Fnd. R.R. Spike/Set K.C. Monument	
	1988	L.C.R.C. #4686	Bueche	K.C. Monument	

The position of this corner was previously approved by the Kent County Remonumentation Peer Group monumented by Jonker Land Surveys on 3/18/82 and was recorded per L.C.R.C. #2705.

B. Description of corner evidence found and/or method applied in restoring or reestablishing corner:

1-4 Found K.C. Monument at Burlingame Avenue running N-S and Porter Street running E-W per L.C.R.C.'s #2705 and #4686 as set by Rob Jonker in place of a R.R. spike he found which checks L.C.R.C.'s #397 and #832.

L.C.R.C. #4686

L.C.R.C. #2705


Remon. tag SE side p. pole S 40° W 44.52'

Remon. tag SE side p. pole S 40° W 44.52'

The selected location is accepted by me and is generally accepted by professional surveyors as the best available evidence of the position of the original corner.

C. Description of monument for corner and accessories established to perpetuate locating the position of the corner:

1-4 Standard Kent County Monument  
Nail & K.C. remon. tag SE side p. pole S 40° W 44.52'  
Nail & K.C. remon. tag W side guy pole N 56° E 46.15'  
Nail & K.C. remon. tag p. pole & lt. pole NE side N 45° W 60.00'  
C/L M.H. N 90° E 59.85'

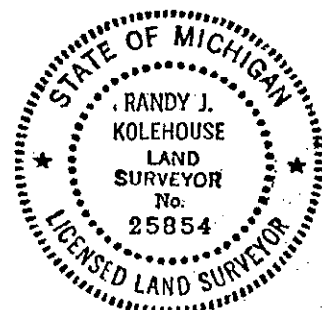

igned by Randy J. Kolehouse  
urveyor's Michigan License No. 25854

Date 11/21/94