

SURVEY & REMONUMENTATION

Kent County Remonumentation

STATE OF MICHIGAN
COUNTY OF KENT
RECEIVED FOR RECORD

APR 28 1995

LAND CORNER RECORDATION CERTIFICATE
Filing Requirement of Act 74, Mich. P.A. 1970

94 NOV 29 AM 9:23

For corners in
Kent **COMMISSION**
(County)

Located In: Corner Code #

1. Public Land Survey	T <u>6N</u> R <u>12W</u>	<u>1-5</u>
	T _____ R _____	_____
	T _____ R _____	_____
	T _____ R _____	_____
2. Property Controlling in Section	S _____ T _____ R _____	_____
	S _____ T _____ R _____	_____
3. Miscellaneous Property in Sec.	S _____ T _____ R _____	_____
	S _____ T _____ R _____	_____

Tim Bond
REG. OF DEEDS

7467

Register of Deeds Stamp & File Number

4. Lot No. _____, Recorded Plat _____
5. Private Claims _____

	A	B	C	D	E	F	G	H	I	J	K	L	M
2	6	5	4	3	2	1							
3													
4	7	8	9	10	11	12							
5													
6	18	17	16	15	14	13							
7													
8	19	20	21	22	23	24							
9													
10	30	29	28	27	26	25							
11													
12	31	32	33	34	35	36							
13													

I, Randy Kolehouse, in a field survey on April 21, 19 94, do hereby certify that under requirements of P.A. 74, Michigan P.A. of 1970, the corner points mentioned in lines 1 and 2 above were in conformance with regulations and rules therefore as required in the current manual of survey instructions of the United States Department of the Interior, Bureau of Land Management or by a decree of a Court of Law and/or that the corner points mentioned in lines 3, 4 and 5 above were in conformance with the rules of the Michigan Board of Land Surveyors or by a Decree of a Court of Law; established, re-established, monumented, re-monumented, recovered, found as expressed below:

NOTE: Not more than 4 corners, all in the same town and range, may be recorded on this certificate.

A. Description of original monument and accessories and/or subsequent restoration:

I-5	1831	G.L.O. Notes	L. Lyon	Set Post
	??	Wit. Map	K.C. Surveyor	Iron
	1973	L#494	Williams & Works	1/2" Iron in Mon. Box
	1975	L.C.R.C. #832	Moore & Bruggink	Mon. Box
	1982	L.C.R.C. #3039	Jonker	Fnd. 1/2" Iron in Mon. Box/Set K.C. Mon.
	1988	L.C.R.C. #4687	Bueche	K.C. Monument

P.A. 345 1990 KENT COUNTY
PEER APPROVED 8/11/94
CHAIRMAN *Harry Huber*

The position of this corner was previously approved by the Kent County Remonumentation Peer Group monumented by Jonker Land Surveys on 7/21/82 and was recorded per L.C.R.C. #3039.

B. Description of corner evidence found and/or method applied in restoring or reestablishing corner:

I-5 Found K.C. Monument in C/L Burlingame Avenue running N-S on C/L 28th Street running E-W as set by Rob Jonker in over the top of a 1/2" iron in monument box 10" below road surface he found which checked L.C.R.C.'s #494 and #832.

L.C.R.C. #4687

L.C.R.C. #3039


Remon. tag SW side g. pole N 40° W 67.30'
Remon. tag E side p. pole S 30° W 77.15'
Remon. tag W side t. pole S 20° E 79.35'
C/L M.H. S 10° W 49.40'
C/L M.H. N 10° W 46.17'
C/L M.H. N 45° E 66.60'

Remon. tag SW side g. pole N 40° W 67.30'
Remon. tag E side p. pole S 30° W 77.15'
Remon. tag W side t. pole S 20° E 79.35'
C/L M.H. S 10° W 49.40'
C/L M.H. N 10° W 46.17'
C/L M.H. N 45° E 66.60'

The selected location is accepted by me and is generally accepted by professional surveyors as the best available evidence of the position of the original corner.

C. Description of monument for corner and accessories established to perpetuate locating the position of the corner:

I-5 Standard Kent County Monument
Nail & K.C. remon. tag SW side g. pole N 40° W 67.40'
Nail & K.C. remon. tag E side p. pole S 30° W 77.30'
Nail & K.C. remon. tag W side t. pole S 20° E 79.73'
C/L M.H. S 10° W 49.40'
C/L M.H. N 10° W 46.17'
C/L M.H. N 45° E 66.60'

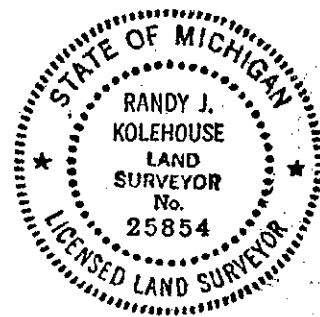

Signed by *Randy J. Kolehouse*

Date 11/21/94

Surveyor's Michigan License No. 25854