

SURVEY & REMONUMENTATION

Kent County Remonumentation

STATE OF MICHIGAN
COUNTY OF KENT
RECEIVED FOR RECORD

APR 28 1995

LAND CORNER RECORDATION CERTIFICATE
Filing Requirement of Act 74, Mich. P.A. 1970

NOV 29 AM 9:23

For corners in **COMMISSION**
Kent

(County)	Located In:	Corner Code #
1. Public Land Survey	T <u>6N</u> R <u>12W</u>	<u>1-8</u>
	T _____ R _____	_____
	T _____ R _____	_____
	T _____ R _____	_____
2. Property Controlling in Section	S _____ T _____ R _____	_____
	S _____ T _____ R _____	_____
3. Miscellaneous Property in Sec.	S _____ T _____ R _____	_____
	S _____ T _____ R _____	_____

Wendy Bond
REG. OF DEEDS

7470

Register of Deeds Stamp & File Number

4. Lot No. _____, Recorded Plat _____
5. Private Claims _____

	A	B	C	D	E	F	G	H	I	J	K	L	M
2	6	5	4	3	2	1							
3													
4	7	8	9	10	11	12							
5													
6	18	17	16	15	14	13							
7													
8	19	20	21	22	23	24							
9													
10	30	29	28	27	26	25							
11													
12	31	32	33	34	35	36							
13													

I, Randy Kolehouse, in a field survey on April 1, 19 94
do hereby certify that under requirements of P.A. 74, Michigan P.A. of 1970, the corner points mentioned in lines 1 and 2 above were in conformance with regulations and rules therefore as required in the current manual of survey instructions of the United States Department of the Interior, Bureau of Land Management or by a decree of a Court of Law and/or that the corner points mentioned in lines 3, 4 and 5 above were in conformance with the rules of the Michigan Board of Land Surveyors or by a Decree of a Court of Law; established, re-established, monumented, re-monumented, recovered, found as expressed below:

NOTE: Not more than 4 corners, all in the same town and range, may be recorded on this certificate.

A. Description of original monument and accessories and/or subsequent restoration:

I-8	1831	G.L.O. Notes	L. Lyon	Set Post
	1951	Wit. Map	K.C. Surveyor	1/2" Iron
	1957	Wit. Map	K.C. Surveyor	Mon. Box
	1973	L.C.R.C. #370	Exxel Engineering	"T" Iron
	1982	L.C.R.C. #2696	Jonker	Fnd. "T" Iron/Set K.C. Mon.
	1988	L.C.R.C. #4689	J. Bueche	K.C. Mon.

P.A. 345 1990 KENT COUNTY
PEER APPROVED 7/28/99
CHAIRMAN *[Signature]*

This corner was originally approved by the Kent County Remonumentation Peer Group monumented by Jonker Land Surveys on 2/19/82 recorded per L.C.R.C. #2696.

B. Description of corner evidence found and/or method applied in restoring or reestablishing corner:

I-8 Found K.C. Monument on C/L Burlingame Avenue running N-S on C/L 40th Street running E and gravel drive running W per L.C.R.C.'s #2696 and #4689 as set by Rob Jonker in place of a "T" Iron he found which checks L.C.R.C. #370.


L.C.R.C. #2696
Nail & K.C. remon. tag on SW side p. pole N 50° W 29.48'
SW cor. house brick N 50° E 107.13'
NW cor. house brick S 45° E 101.40'
C/L M.H. S 70° E 32.51'
C/L M.H. N 35° W 7.23'
On N-S C/L, in line C/L to E

L.C.R.C. #4689
K.C. remon. tag on SW side p. pole N 50° W 29.48'
SW cor. house brick N 50° E 107.13'
NW cor. house brick S 45° E 101.40'
C/L M.H. S 70° E 32.51'
C/L M.H. N 35° W 7.23'
On N-S C/L, in line C/L to E

The selected location is accepted by me and is generally accepted by professional surveyors as the best available evidence of the position of the original corner.

C. Description of monument for corner and accessories established to perpetuate locating the position of the corner:

I-8 Standard Kent County Monument
Nail & K.C. remon. tag on SW side p. pole N 50° W 29.48'
SW cor. house brick N 50° E 107.13'
NW cor. house brick S 45° E 101.40'
C/L M.H. S 70° E 32.51'
C/L M.H. N 35° W 7.23'

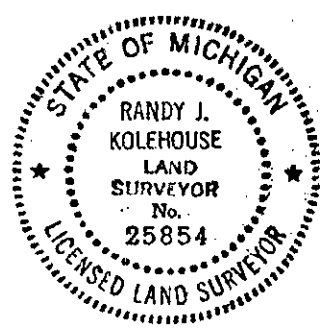

Signed by *[Signature]*
Surveyor's Michigan License No. 25854

Date 11/21/94