SURVEY & REMONUMENTATION

APR 28 1995

COMMISSION

Kent County Remonumentation

STATE OF MICHIGAN
COUNTY OF KENT
RECEIVED FOR RECORD
94 NOV 29 AM 9:23

REG. OF DEEDS

LAND CORNER RECORDATION CERTIFICATE
Filing Requirement of Act 74, Mich. P.A. 1970

For corners in Kent (County)

	Located In:	Corner Code #
1. Public Land Survey	T 6N R 12W	I-9
	T ___ R ___	
	T ___ R ___	
	T ___ R ___	
2. Property Controlling	S ___ T ___ R ___	
in Section	S ___ T ___ R ___	
3. Miscellaneous	S ___ T ___ R ___	
Property in Sec.	S ___ T ___ R ___	

7471
Register of Deeds Stamp & File Number

4. Lot No. _____, Recorded Plat _____
5. Private Claims _____

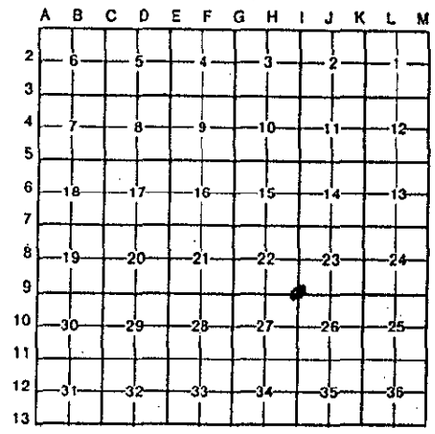

I, Randy Kolehouse, in a field survey on April 5, 19 94, do hereby certify that under requirements of P.A. 74, Michigan P.A. of 1970, the corner points mentioned in lines 1 and 2 above were in conformance with regulations and rules therefore as required in the current manual of survey instructions of the United States Department of the Interior, Bureau of Land Management or by a decree of a Court of Law and/or that the corner points mentioned in lines 3, 4 and 5 above were in conformance with the rules of the Michigan Board of Land Surveyors or by a Decree of a Court of Law; established, re-established, monumented, re-monumented, recovered, found as expressed below:

NOTE: Not more than 4 corners, all in the same town and range, may be recorded on this certificate.

A. Description of original monument and accessories and/or subsequent restoration:

I-9	1831	G.L.O. Notes	L. Lyon	Set Post
	1957	Wit. Map	K.C. Surveyor	Iron
	1976	L.C.R.C. #993	Medema Van Kooten	Bt. Spike
	1981	L.C.R.C. #1965	Exxel Engineering	Fnd. 3/4" Iron in Mon. Box/Set K.C. Mon
	1988	L.C.R.C. #4690	John Bueche	K.C. Mon.

P.A. 345 1990 KENT COUNTY
PEER APPROVED 7/28/94
CHAIRMAN Harry Huber

This corner was originally approved by the Kent County Remonumentation Peer Group and monumented by Exxel Engineering, Inc., on 8/81 and was recorded per L.C.R.C. #1965.

B. Description of corner evidence found and/or method applied in restoring or reestablishing corner:

I-9 Found K.C. Monument in 44th Street running E-W per L.C.R.C.'s #1965 and #4690 as set by Exxel Engineering in place of a 3/4" iron in monument box which checks L.C.R.C. #993 and Exxel Engineering survey records.

L.C.R.C. #1965	L.C.R.C. #4690
Nail & K.C. remon tag in SE side clump of 4 14" Oaks N 50° E 121.08'	Nail & K.C. remon tag in SE side clump of 4 14" Oaks N 50° E 121.08'
C/L top hydrant N 39° E 72.66'	C/L top hydrant N 39° E 72.66'
NW cor. bldg. fndn. S 15° W 94.14'	NW cor. bldg. fndn. S 15° W 94.14'
C/L hydrant S 87° W 163.93'	C/L hydrant S 87° W 163.93'
Cor. is 5.7' N of C/L 26.1' wide E-bound lane of 44th St.	Cor. is 5.7' N of C/L 26.1' wide E-bound lane of 44th St.

The selected location is accepted by me and is generally accepted by professional surveyors as the best available evidence of the position of the original corner.

C. Description of monument for corner and accessories established to perpetuate locating the position of the corner:

I-9 Standard Kent County Monument
Nail & K.C. remon tag in SE side clump of 4 14" Oaks N 50° E 121.08'
C/L top hydrant N 39° E 72.66'
NW cor. bldg. fndn. S 15° W 94.14'
C/L hydrant S 87° W 163.93'
Cor. is 5.7' N of C/L 26.1' wide E-bound lane of 44th St.

STATE OF MICHIGAN
RANDY J. KOLEHOUSE
LAND SURVEYOR
No. 25854
LICENSED LAND SURVEYOR

Signed by Randy J Kolehouse Date 11/21/94
Surveyor's Michigan License No. 25854

FORM APPROVED BY MICHIGAN STATE BOARD OF LAND SURVEYORS, JAN. 28, 1971
REVISED MAY 14, 1975
REVISED JAN., 1983