

SURVEY & REMONUMENTATION

Kent County Remonumentation

STATE OF MICHIGAN
COUNTY OF KENT
RECEIVED FOR RECORD

APR 28 1995

LAND CORNER RECORDATION CERTIFICATE
Filing Requirement of Act 74, Mich. P.A. 1970

NOV 29 AM 9:23

For corners in Kent **COMMISSION**

(County)	Located In:	Corner Code #
1. Public Land Survey	T 6N R 12W	I-11
	T _____ R _____	_____
	T _____ R _____	_____
	T _____ R _____	_____
2. Property Controlling in Section	S _____ T _____ R _____	_____
	S _____ T _____ R _____	_____
3. Miscellaneous Property in Sec.	S _____ T _____ R _____	_____
	S _____ T _____ R _____	_____

Tim J. Bond
REG. OF DEEDS

7472

Register of Deeds Stamp & File Number

4. Lot No. _____, Recorded Plat _____
5. Private Claims _____

	A	B	C	D	E	F	G	H	I	J	K	L	M
2	6		5		4		3		2		1		
3													
4	7		8		9		10		11		12		
5													
6	16		17		18		15		14		13		
7													
8	19		20		21		22		23		24		
9													
10	30		29		28		27		26		25		
11													
12	31		32		33		34		35		36		
13													

I, Randy Kolehouse, in a field survey on March 24, 1994, do hereby certify that under requirements of P.A. 74, Michigan P.A. of 1970, the corner points mentioned in lines 1 and 2 above were in conformance with regulations and rules therfore as required in the current manual of survey instructions of the United States Department of the Interior, Bureau of Land Management or by a decree of a Court of Law and/or that the corner points mentioned in lines 3, 4 and 5 above were in conformance with the rules of the Michigan Board of Land Surveyors or by a Decree of a Court of Law; established, re-established, monumented, re-monumented, recovered, found as expressed below:

NOTE: Not more than 4 corners, all in the same town and range, may be recorded on this certificate.

A. Description of original monument and accessories and/or subsequent restoration:

I-11	1831	G.L.O. Notes	L. Lyon	Set Post
	N/A	Wit. Map	K.C. Surveyor	3/4" Iron
	1972	L.C.R.C. #278	Medema Van Kooten	Square Spike
	1981	Survey Records	Exxel Engineering	Square Spike
	1981	L.C.R.C. #1830	Exxel Engineering	Fnd. Square Spike & Iron/Set K.C. Mon.
	1988	L.C.R.C. #4692	John Bueche	K.C. Monument

P.A. 345 1990 KENT COUNTY
PEER APPROVED 7/28/94
CHAIRMAN *Harry Huber*

This corner was originally approved by the Kent County Remonumentation Peer Group and monumented by Exxel Engineering, Inc., on 6/2/81 and was recorded per L.C.R.C. #1830.

B. Description of corner evidence found and/or method applied in restoring or reestablishing corner:

I-11 Found standard Kent County Monument in C/L of 52nd Street running E-W on C/L of Clyde Park Avenue running South per L.C.R.C. #1830 as set by Exxel Engineering in place of a square spike they found which checked L.C.R.C. #278.

L.C.R.C. #1830

L.C.R.C. #4692


Nail & K.C. remon. tag in S side 26" Oak N 70° W 88.26'
Chiseled "X" in top of concrete culvert pipe S 49° E 56.93'

Nail & K.C. remon. tag in S side 28" Oak N 70° W 88.26'
Nail in S side 38" Oak N 86° E 233.97'
Chiseled "X" in top of conc. culvt. S 61 E 56.93'
Chiseled "X" in top of conc. culvt. N 54° E 53.20'
Center of top of hydt. S 39° W 42.45'
C/L E-W bit. road 1' N M/L - On C/L bit road S
C/L bit. road N 8' W M/L - P.K. nail E & S 2.00'

The selected location is accepted by me and is generally accepted by professional surveyors as the best available evidence of the position of the original corner.

Description of monument for corner and accessories established to perpetuate locating the position of the corner:

I-11 Standard Kent County Monument
Nail & K.C. remon. tag in S side 28" Oak N 70° W 88.26'
Nail in S side 38" Oak N 86° E 233.97'
Chiseled "X" in top of conc. culvt. S 61 E 56.93'
Chiseled "X" in top of conc. culvt. N 54° E 53.20'
Center of top of hydt. S 39° W 42.45'
C/L E-W bit. road 1' N M/L - On C/L bit road S
C/L bit. road N 8' W M/L - P.K. nail E & S 2.00'

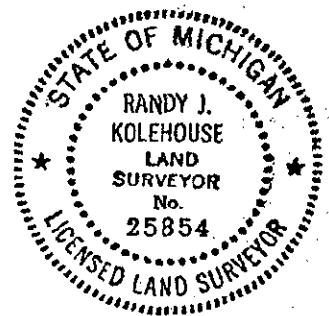

Surveyed by *Randy J. Kolehouse*
Surveyor's Michigan License No. 25854

Date 11/21/94