

**SURVEY & REMONUMENTATION**

Kent County Remonumentation

STATE OF MICHIGAN  
COUNTY OF KENT  
RECEIVED FOR RECORD

**LAND CORNER RECORDATION CERTIFICATE**

Filing Requirement of Act 74, Mich. P.A. 1970

95 NOV 29 AM 9:23

APR 28 1995

For corners in

Kent

**COMMISSION**

Located In:

Corner Code #

(County)

- 1. Public Land Survey      T 6N    R 12W      J-7
- T        R
- T        R
- T        R
- 2. Property Controlling    S        T        R
- in Section                S        T        R
- 3. Miscellaneous            S        T        R
- Property in Sec.         S        T        R
- 4. Lot No. \_\_\_\_\_, Recorded Plat \_\_\_\_\_
- 5. Private Claims \_\_\_\_\_

*W. J. Bond*  
REG. OF DEEDS

7478

Register of Deeds Stamp & File Number

I, Randy Kolehouse, in a field survey on June 8, 19 94, do hereby certify that under requirements of P.A. 74, Michigan P.A. of 1970, the corner points mentioned in lines 1 and 2 above were in conformance with regulations and rules therefore as required in the current manual of survey instructions of the United States Department of the Interior, Bureau of Land Management or by a decree of a Court of Law and/or that the corner points mentioned in lines 3, 4 and 5 above were in conformance with the rules of the Michigan Board of Land Surveyors or by a Decree of a Court of Law; established, re-established, monumented, re-monumented, recovered, found as expressed below:

A	B	C	D	E	F	G	H	I	J	K	L	M
2	6	5	4	3	2	1						
3												
4	7	8	9	10	11	12						
5												
6	18	17	16	15	14	13						
7												
8	19	20	21	22	23	24						
9												
10	30	29	28	27	26	25						
11												
12	31	32	33	34	35	36						
13												

**NOTE: Not more than 4 corners, all in the same town and range, may be recorded on this certificate.**

A. Description of original monument and accessories and/or subsequent restoration:

J-7	1831	G.L.O. Notes	L. Lyon	Set Post	P.A. 345 1990 KENT COUNTY
	1939	Wit. Map	K.C. Surveyor	Iron	PEER APPROVED 7/28/94
	1974	L.C.R.C. #681	Exxel Eng	1/2" Iron	CHAIRMAN <i>Darryl Huber</i>
	1982	L.C.R.C. #3040	Jonker	Fnd 1/2" Iron	
	1988	L.C.R.C. #4697	John Beuche	Set K.C. Mon.	
				K.C. Mon.	

This corner was originally approved by the Kent County Remonumentation Peer Group monumented by Jonker Land Surveys on 7/20/82 and was recorded per L.C.R.C. #3040.

B. Description of corner evidence found and/or method applied in restoring or reestablishing corner:

J-7 Found K.C. Monument per L.C.R.C. #3040 and #4697 as set by Rob Jonker in place of a 1/2" iron set by Exxel Eng. using surrounding subdivisions. This point checks with L.C.R.C #3040 and #4697, also 1939 K.C. Surveyor records.

L.C.R.C. #3040

L.C.R.C. #4697

K.C. remon. tag on SE side t. pole S 50° W 50.23'  
K.C. remon. tag on SW side t. pole S 50° E 52.40'  
K.C. remon. tag on NE side p. pole N 50° W 54.27'  
C/L M.H. N 70° W 16.37'  
C/L M.H. S 35° E 7.00'  
On C/L "X" intersection


K.C. remon. tag on SE side t. pole S 50° W 50.23'  
K.C. remon. tag on SW side t. pole S 50° E 52.40'  
K.C. remon. tag on NE side p. pole N 50° W 54.27'  
C/L M.H. N 70° W 16.37'  
C/L M.H. S 35° E 7.00'  
On C/L "X" intersection

C. Description of monument for corner and accessories established to perpetuate locating the position of the corner:

J-7 The selected location is accepted by me and is generally accepted by professional surveyors as the best available evidence of the position of the original corner.

Standard Kent County Monument

K.C. remon. tag on SE side t. pole S 50° W 50.23'  
K.C. remon. tag on SW side t. pole S 50° E 52.40'  
K.C. remon. tag on NE side p. pole N 50° W 54.27'  
C/L M.H. N 70° W 16.37'  
C/L M.H. S 35° E 7.00'  
At C/L "X" intersection

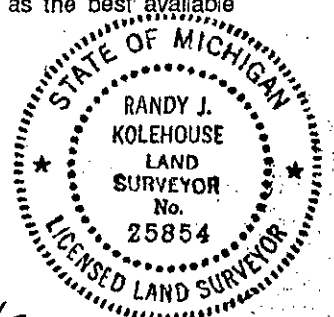

igned by *Randy J. Kolehouse*  
urveyor's Michigan License No. 25854

Date 11/21/94