

# SURVEY & REMONUMENTATION

STATE OF MICHIGAN  
COUNTY OF KENT  
RECEIVED FOR RECORD

APR 28 1995

## LAND CORNER RECORDATION CERTIFICATE Filing Requirement of Act 74, Mich. P.A. 1970 KENT COUNTY REMONUMENTATION

94 DEC -6 AM 8:58

For corners in

Kent **COMMISSION**  
(County)

Located in:

Corner Code #

1. Public Land Survey	T	6N	R	12W	J-8	
	T		R			
	T		R			
	T		R			
	T		R			
2. Property Controlling in Section	S	T	R			
	S	T	R			
3. Miscellaneous Property in Sec.	S	T	R			
	S	T	R			

*W. J. Bond*  
REG. OF DEEDS

7748

Register of Deeds Stamp & File Number

4. Lot No. \_\_\_\_\_, Recorded Plat \_\_\_\_\_  
5. Private Claims \_\_\_\_\_

	A	B	C	D	E	F	G	H	I	J	K	L	M
2	6		5		4		3		2		1		
3													
4	7		8		9		10		11		12		
5													
6	18		17		16		15		14		13		
7													
8	19		20		21		22		23		24		
9													
10	30		29		28		27		26		25		
11													
12	31		32		33		34		35		36		
13													

I, Randy Kolehouse, in a field survey on October 8 19 94, do hereby certify that under requirements of P.A. 74 Michigan P.A. of 1970, the corner points mentioned in lines 1 and 2 above were in conformance with regulations and rules therefore as required in the current manual of survey instructions of the United States Department of the interior, Bureau of Land Management or by a decree of a Court of Law and/or that the corner points mentioned in lines 3, 4 and 5 above were in conformance with the rules of the Michigan Board of Land Surveyors or by a Decree of a Court of Law; established, re-established, monumented, re-monumented, recovered, found as expressed below:

**NOTE: Not more than 4 corners, all in the same town and range, may be recorded on this certificate.**

A. Description of original monument and accessories and/or subsequent restoration:

J-8 This corner was not originally set by the G.L.O.

1940-1958	Survey Records	Williams & Works	Conc. Monument
1958	Survey Records	Williams & Works	Bt. Spike
1961	Survey Records	Williams & Works	Monument Box

B. Description of corner evidence found and/or method applied in restoring or reestablishing corner:


J-8 Found 1 1/2" square iron in monument box in 40th Street running E-W. This point checks survey records of Williams & Works from 1940-1961 and has been used continually since 1940. Iron in monument box is 1.5' South and 1.7' West of intersection of 1/4 line.

P.A. 345 1990 KENT COUNTY  
PEER APPROVED 8/29/94  
CHAIRMAN *Harry Huber*

C. Description of monument for corner and accessories established to perpetuate locating the position of the corner:

J-8 Replaced iron with Standard 4" x 30" Kent County Monument in a monument box.

- Nail & K.C. remon. tag in W side p. pole North 24.99'
- Nail & K.C. remon. tag in W side 10" Oak S 40° W 59.59'
- Nail & K.C. remon. tag in SW side 18" Oak S 30° E 57.11'
- SE corner hse. ind. (#1209) N 40° W 75.00'

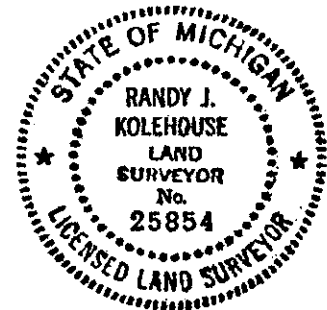

Signed by *Randy J. Kolehouse* Date 12/1/94  
Surveyor's Michigan License No. 25854