

SURVEY & REMONUMENTATION

APR 28 1995

LAND CORNER RECORDATION CERTIFICATE Filing Requirement of Act 74, Mich. P.A. 1970

STATE OF MICHIGAN
COUNTY OF KENT
RECEIVED FOR RECORD

DEC -6 AM 8:58

For corners in COMMISSION
Kent
(County)

Located in:	Corner Code #
T <u>6N</u> R <u>12W</u>	<u>J-10</u>
T _____ R _____	_____
T _____ R _____	_____
T _____ R _____	_____
S _____ T _____ R _____	_____
S _____ T _____ R _____	_____
S _____ T _____ R _____	_____
S _____ T _____ R _____	_____

W. J. Bond
REG. OF DEEDS

7745

Register of Deeds Stamp & File Number

- 4. Lot No. _____, Recorded Plat _____
- 5. Private Claims _____

	A	B	C	D	E	F	G	H	I	J	K	L	M
2	6	5	4	3	2	1							
3													
4	7	8	9	10	11	12							
5													
6	18	17	16	15	14	13							
7													
8	19	20	21	22	23	24							
9													
10	30	29	28	27	26	25							
11													
12	31	32	33	34	35	36							
13													

I, Randy Kolehouse, in a field survey on November 8 19 94, do hereby certify that under requirements of P.A. 74 Michigan P.A. of 1970, the corner points mentioned in lines 1 and 2 above were in conformance with regulations and rules therefore as required in the current manual of survey instructions of the United States Department of the Interior, Bureau of Land Management or by a decree of a Court of Law and/or that the corner points mentioned in lines 3, 4 and 5 above were in conformance with the rules of the Michigan Board of Land Surveyors or by a Decree of a Court of Law; established, re-established, monumented, re-monumented, recovered, found as expressed below:

NOTE: Not more than 4 corners, all in the same town and range, may be recorded on this certificate.

A. Description of original monument and accessories and/or subsequent restoration:

J-10 This corner was not originally set by the G.L.O.

1927	Survey Records	Williams & Works	Set Iron
1927	Survey Records	Williams & Works	Used Same Iron

B. Description of corner evidence found and/or method applied in restoring or reestablishing corner:


J-10 Williams & Works set an iron for the Center Section at the intersection of 1/4 lines and has used same ever since. Corner now falls in the center of lines Palmer Park. Found iron (no wits.) 0.4' South and 0.7' East of intersection of 1/4 lines. Accepted as Center Section.

P.A. 345 1990 KENT COUNTY
PEER APPROVED 9/22/94
CHAIRMAN *[Signature]*

C. Description of monument for corner and accessories established to perpetuate locating the position of the corner:

J-10 Replaced iron with a Standard 4" x 30" Kent County Monument.

- Nail & K.C. remon. tag in N side 14" Oak S 80° W 71.57'
- Nail & K.C. remon. tag in W side 10" Oak South 38.43'
- Nail & K.C. remon. tag in E side 32" Birch N 75° W 14.97'
- Nail & K.C. remon. tag in W side 16" Oak N 25° E 16.55'
- Nail & K.C. remon. tag in N side 16" Oak N 80° E 29.02'

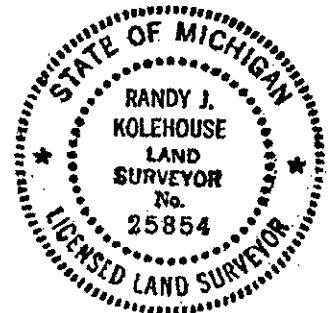

Signed by Randy J. Kolehouse Date 12/1/94
Surveyor's Michigan License No. 25854