

# SURVEY & REMONUMENTATION

APR 28 1995

## COMMISSION

For corners in

### LAND CORNER RECORDATION CERTIFICATE Filing Requirement of Act 74, Mich. P.A. 1970 KENT COUNTY REMONUMENTATION

STATE OF MICHIGAN  
COUNTY OF KENT  
RECEIVED FOR RECORD

94 DEC -6 AM 8:59

*Lucy Bond*  
REG. OF DEEDS

Kent (County)	Located in:	Corner Code #
1. Public Land Survey	T <u>6N</u> R <u>12W</u>	<u>J-12</u>
	T _____ R _____	_____
	T _____ R _____	_____
	T _____ R _____	_____
2. Property Controlling in Section	S _____ T _____ R _____	_____
	S _____ T _____ R _____	_____
3. Miscellaneous Property in Sec.	S _____ T _____ R _____	_____
	S _____ T _____ R _____	_____

7752

Register of Deeds Stamp & File Number

- 4. Lot No. \_\_\_\_\_, Recorded Plat \_\_\_\_\_
- 5. Private Claims \_\_\_\_\_

	A	B	C	D	E	F	G	H	I	J	K	L	M
2	6		5		4		3		2		1		
3													
4	7		8		9		10		11		12		
5													
6	16		17		18		15		14		13		
7													
8	19		20		21		22		23		24		
9													
10	30		29		28		27		26		25		
11													
12	31		32		33		34		35		36		
13													

I, Randy Kolehouse, in a field survey on April 19 19 94, do hereby certify that under requirements of P.A. 74 Michigan P.A. of 1970, the corner points mentioned in lines 1 and 2 above were in conformance with regulations and rules therefore as required in the current manual of survey instructions of the United States Department of the Interior, Bureau of Land Management or by a decree of a Court of Law and/or that the corner points mentioned in lines 3, 4 and 5 above were in conformance with the rules of the Michigan Board of Land Surveyors or by a Decree of a Court of Law; established, re-established, monumented, re-monumented, recovered, found as expressed below:

NOTE: Not more than 4 corners, all in the same town and range, may be recorded on this certificate.

A. Description of original monument and accessories and/or subsequent restoration:

- J-12 This corner was not originally set by the G.L.O.
- 1907 Survey Records Williams & Works Fnd. Iron
- 1947 Survey Records Williams & Works Iron
- 1953 Survey Records Williams & Works Iron
- 1974 L.C.R.C. #681 Exxel Engineering 3/4" Iron


B. Description of corner evidence found and/or method applied in restoring or reestablishing corner:

J-12 Found 3/4" solid iron C/L of 56th Street per L.C.R.C. #681. Iron checks Williams & Works dist. (1907) to North 1/4 and East 1/4 + 3' and Williams & Works dist. (1953) to W 1/4 within 1.3 feet, and Williams & Works dist. (1947) to S 1/4 within 1.3 feet. Iron is 2.5' South and 2.7' East of intersection of 1/4 lines. Accepted iron as Center Section.

P.A. 345 1990 KENT COUNTY  
PEER APPROVED 7/28/99  
CHAIRMAN Harry Huber

C. Description of monument for corner and accessories established to perpetuate locating the position of the corner:

- J-12 Replaced iron with a Standard 4" x 30" Kent County Monument (Harrison).
- Nail and Exxel cap in E side 12" Ash S 05° E 51.15'
- SW corner garage N 25° E 83.80'
- P.K. in side p. pole N 75° E 98.43'
- P.K. in side t. pole S 45° E 45.06'

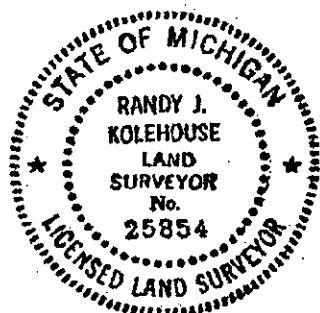

Signed by Randy J. Kolehouse Date 12/1/94  
Surveyor's Michigan License No. 25854