

SURVEY & REMONUMENTATION

Kent County Remonumentation

STATE OF MICHIGAN
COUNTY OF KENT
RECEIVED FOR RECORD

APR 28 1995

LAND CORNER RECORDATION CERTIFICATE NOV 29 AM 9:23
Filing Requirement of Act 74, Mich. P.A. 1970

For corners in **COMMISSION**
Kent (County)

Located In: Corner Code #

Tim J. Bond
REG. OF DEEDS

- | | | | |
|------------------------------------|------|-------|-----|
| 1. Public Land Survey | T 6N | R 12W | K-5 |
| | T | R | |
| | T | R | |
| | T | R | |
| 2. Property Controlling in Section | S | T | R |
| | S | T | R |
| 3. Miscellaneous Property in Sec. | S | T | R |
| | S | T | R |

7486

Register of Deeds Stamp & File Number

4. Lot No. _____, Recorded Plat _____
5. Private Claims _____

	A	B	C	D	E	F	G	H	I	J	K	L	M
2	6	5	4	3	2	1							
3													
4	7	8	9	10	11	12							
5													
6	18	17	16	15	14	13							
7													
8	19	20	21	22	23	24							
9													
10	30	29	28	27	26	25							
11													
12	31	32	33	34	35	36							
13													

I, Randy Kolehouse, in a field survey on April 21, 19 94, do hereby certify that under requirements of P.A. 74, Michigan P.A. of 1970, the corner points mentioned in lines 1 and 2 above were in conformance with regulations and rules therefore as required in the current manual of survey instructions of the United States Department of the Interior, Bureau of Land Management or by a decree of a Court of Law and/or that the corner points mentioned in lines 3, 4 and 5 above were in conformance with the rules of the Michigan Board of Land Surveyors or by a Decree of a Court of Law; established, re-established, monumented, re-monumented, recovered, found as expressed below:

NOTE: Not more than 4 corners, all in the same town and range, may be recorded on this certificate.

A. Description of original monument and accessories and/or subsequent restoration:

- | | | | | |
|-----|------|----------------|------------------|--|
| K-5 | 1831 | G.L.O. Notes | L. Lyon | Set Post |
| | 1948 | Wit. Map | K.C. Surveyor | ++ in Pavement |
| | 1976 | L.C.R.C. #930 | Moore & Bruggink | Iron |
| | 1984 | L.C.R.C. #4098 | Rosema | Found Mon. Box and "+" in Pavement/Set K.C. Mon. |
| | 1988 | L.C.R.C. #4743 | Bueche | K.C. Mon. |

P.A. 345 1990 KENT COUNTY

PEER APPROVED 8/11/94
CHAIRMAN Harry Stuber

- K-5 The position of this corner was previously approved by the Kent County Remonumentation Peer Group monumented by Maurice J. Rosema on 11/25/84 and was recorded per L.C.R.C. #4098 and also monumented on 7/16/88 per L.C.R.C. #4743.

B. Description of corner evidence found and/or method applied in restoring or reestablishing corner:

- K-5 Found K.C. Monument per L.C.R.C. #4098 and #4743 as set by M. Rosema in place of an iron in Mon. Box over a "+" cut in concrete pavement he found which checked with K.C. Surveyor's records.

L.C.R.C. #4743

L.C.R.C. #4098


N'y cor. catch basin casting S 30° E 71.38'
Face of 8" dia. steel post S 35° W 76.73'
Nail & remon. tag SE side P. pole N 40° E 60.58'

P.K. nail & remon. tag SE side P. pole N 40° E 60.58'

The selected location is accepted by me and is generally accepted by professional surveyors as the best available evidence of the position of the original corner.

C. Description of monument for corner and accessories established to perpetuate locating the position of the corner:

- K-5 Standard Kent County Monument
Face 8" dia. steel post S 35° W 76.73'
Nail & K.C. remon. tag SE side P. pole N 40° E 60.58'
N'y corner CB casting S 30° E 71.38'
SE cor. metal base cross walk sign N 42° W 65.72'

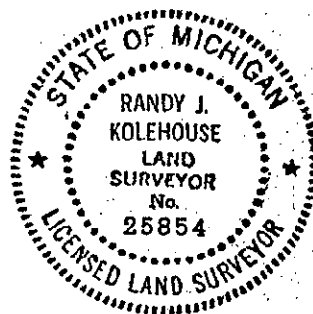

Signed by Randy J. Kolehouse
Surveyor's Michigan License No. 25854

Date 11/21/94