

SURVEY & REMONUMENTATION

Kent County Remonumentation

STATE OF MICHIGAN
COUNTY OF KENT
RECEIVED FOR RECORD

APR 28 1995

LAND CORNER RECORDATION CERTIFICATE
Filing Requirement of Act 74, Mich. P.A. 1970

NOV 29 AM 9:23

COMMISSION

For corners in
Kent

(County)	Located In:	Corner Code #
1. Public Land Survey	T <u>6N</u> R <u>12W</u>	<u>K-6</u>
	T _____ R _____	_____
	T _____ R _____	_____
	T _____ R _____	_____
2. Property Controlling in Section	S _____ T _____ R _____	_____
	S _____ T _____ R _____	_____
3. Miscellaneous Property in Sec.	S _____ T _____ R _____	_____

W. J. Bond
REG. OF DEEDS

7487

Register of Deeds Stamp & File Number

4. Lot No. _____, Recorded Plat _____
5. Private Claims _____

	A	B	C	D	E	F	G	H	I	J	K	L	M
2	6		5		4		3		2		1		
3													
4	7		8		9		10		11		12		
5													
6	18		17		16		15		14		13		
7													
8	19		20		21		22		23		24		
9													
10	30		29		28		27		26		25		
11													
12	31		32		33		34		35		36		
13													

I, Randy Kolehouse, in a field survey on April 21, 19 94, do hereby certify that under requirements of P.A. 74, Michigan P.A. of 1970, the corner points mentioned in lines 1 and 2 above were in conformance with regulations and rules therefore as required in the current manual of survey instructions of the United States Department of the Interior, Bureau of Land Management or by a decree of a Court of Law and/or that the corner points mentioned in lines 3, 4 and 5 above were in conformance with the rules of the Michigan Board of Land Surveyors or by a Decree of a Court of Law; established, re-established, monumented, re-monumented, recovered, found as expressed below:

NOTE: Not more than 4 corners, all in the same town and range, may be recorded on this certificate.

A. Description of original monument and accessories and/or subsequent restoration:

K-6	1831	G.L.O. Notes	L. Lyon	Set Post
	1962	Wit. Map	K.C. Surveyor	Iron
	1990	L.C.R.C. #5330	Bueche	Fnd. Iron/Set K.C. Mon.
	1990	L.C.R.C. #5708	Bueche	K.C. Mon.

P.A. 345 1990 KENT COUNTY

PEER APPROVED 11/11/94
CHAIRMAN [Signature]

This corner was originally approved by the Kent County Remonumentation Peer Group and monumented by John Bueche on 3/23/90 and was recorded per L.C.R.C. #5330.

B. Description of corner evidence found and/or method applied in restoring or reestablishing corner:

K-6 Found K.C. Monument at Clyde Park Ave. & 32nd St. per L.C.R.C. #5330 and #5708 as set by John Bueche in place of a 1" iron he found which checked 1962 K.C. Surveyor's records.

L.C.R.C. #5330

L.C.R.C. #5708


SE cor. house N 62° W 99.77'
NE cor. garage S 58° W 113.20'
NW cor. house S 47° E 102.00'
K.C. remon. tag & nail W side pole N 25° E 90.86'

SE cor. house N 62° W 99.77'
NE cor. garage S 58° W 113.20'
NW cor. house S 47° E 102.00'
K.C. remon. tag & nail W side pole N 25° E 90.86'

K-6 The selected location is accepted by me and is generally accepted by professional surveyors as the best available evidence of the position of the original corner.

C. Description of monument for corner and accessories established to perpetuate locating the position of the corner:

K-6 Standard Kent County Monument
SE cor. house N 62° W 99.77'
NE cor. garage S 58° W 113.20'
NW cor. house S 47° E 102.00'
Nail & K.C. remon. tag W side pole N 25° E 90.86'

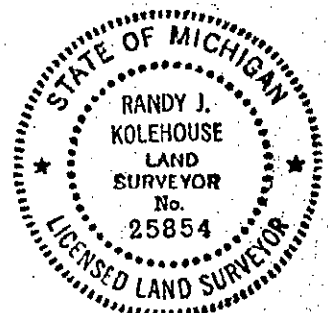

Signed by Randy J. Kolehouse
Surveyor's Michigan License No. 25854

Date 11/21/94