

SURVEY & REMONUMENTATION

Kent County Remonumentation

STATE OF MICHIGAN
COUNTY OF KENT
RECEIVED FOR RECORD

APR 28 1995

LAND CORNER RECORDATION CERTIFICATE
Filing Requirement of Act 74, Mich. P.A. 1970

NOV 29 AM 9:24

COMMISSION

For corners in
Kent

(County)

Located In:

Corner Code #

1. Public Land Survey	T 6N R 12W	K-11
	T _____ R _____	_____
	T _____ R _____	_____
	T _____ R _____	_____
2. Property Controlling in Section	S _____ T _____ R _____	_____
	S _____ T _____ R _____	_____
3. Miscellaneous Property in Sec.	S _____ T _____ R _____	_____
	S _____ T _____ R _____	_____

W. J. Colehouse
REG. OF DEEDS

7491

Register of Deeds Stamp & File Number

4. Lot No. _____, Recorded Plat _____
5. Private Claims _____

	A	B	C	D	E	F	G	H	I	J	K	L	M
2	6	5	4	3	2	1							
3													
4	7	8	9	10	11	12							
5													
6	10	17	16	15	14	13							
7													
8	19	20	21	22	23	24							
9													
10	30	29	28	27	26	25							
11													
12	31	32	33	34	35	36							
13													

I, Randy Kolehouse, in a field survey on March 31, 19 94, do hereby certify that under requirements of P.A. 74, Michigan P.A. of 1970, the corner points mentioned in lines 1 and 2 above were in conformance with regulations and rules therefore as required in the current manual of survey instructions of the United States Department of the Interior, Bureau of Land Management or by a decree of a Court of Law and/or that the corner points mentioned in lines 3, 4 and 5 above were in conformance with the rules of the Michigan Board of Land Surveyors or by a Decree of a Court of Law; established, re-established, monumented, re-monumented, recovered, found as expressed below:

NOTE: Not more than 4 corners, all in the same town and range, may be recorded on this certificate.

A. Description of original monument and accessories and/or subsequent restoration:

K-11	1831	G.L.O. Notes	L. Lyon	Set Post	P.A. 345 1980 KENT COUNTY
	1964	Wit. Map	K.C. Surveyor	Iron in Mon. Box	PEER APPROVED 7/28/94
	1971	L.C.R.C. #102	Williams & Works	3" Iron in Mon. Box	CHAIRMAN <i>[Signature]</i>
	1972	L.C.R.C. #275	Medema Van Kooten	3" Iron in Mon. Box	
	1981	L.C.R.C. #1828	Exxel Engineering	Fnd. P.K./Set K.C. Mon.	
	1988	L.C.R.C. #4707	Bueche	K.C. Mon.	
	1992	L.C.R.C. #6631	Bueche	Reset K.C. Mon.	

This corner was originally approved by the Kent County Remonumentation Peer Group and monumented by Exxel Engineering on 5/5/81 and was recorded per L.C.R.C. #1828.

B. Description of corner evidence found and/or method applied in restoring or reestablishing corner:

K-11 Found K.C. Monument 2' East of West Curb per L.C.R.C. #6631 as reset by Bueche after street construction using L.C.R.C. #1828 to verify. Monument was first set by Exxel Engineering in place of a P.K. nail they found which checked L.C.R.C.'s #102 and #275.


L.C.R.C. #6631

"X" cut in curb N 20° E 117.54'
NW cor. CB header S 45° W 92.57'
NE cor. CB header S 25° E 76.13'
PK in S side of light pole East 40.73'
Face curb W 2.0' ±

The selected location is accepted by me and is generally accepted by professional surveyors as the best available evidence of the position of the original corner.

C. Description of monument for corner and accessories established to perpetuate locating the position of the corner:

K-11 Standard Kent County Monument
"X" cut in curb N 20° E 117.54'
NW cor. CB header S 45° W 92.57'
NE cor. CB header S 25° E 76.13'
PK in S side of light pole East 40.73'

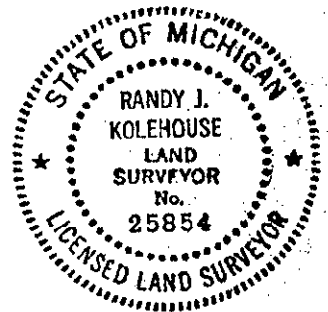

Signed by *Randy J. Kolehouse*
Surveyor's Michigan License No. 25854

Date 11/21/94