

SURVEY & REMONUMENTATION

Kent County Remonumentation

STATE OF MICHIGAN
COUNTY OF KENT
RECEIVED FOR RECORD

APR 28 1995

LAND CORNER RECORDATION CERTIFICATE
Filing Requirement of Act 74, Mich. P.A. 1970

NOV 29 AM 9:24

COMMISSION

For corners in
Kent

(County)	Located In:	Corner Code #
1. Public Land Survey	T <u>6N</u> R <u>12W</u>	<u>K-12</u>
	T _____ R _____	_____
	T _____ R _____	_____
	T _____ R _____	_____
2. Property Controlling in Section	S _____ T _____ R _____	_____
	S _____ T _____ R _____	_____
3. Miscellaneous Property in Sec.	S _____ T _____ R _____	_____
	S _____ T _____ R _____	_____

W. J. Bond
REG. OF DEEDS

7492

Register of Deeds Stamp & File Number

4. Lot No. _____, Recorded Plat _____
5. Private Claims _____

	A	B	C	D	E	F	G	H	I	J	K	L	M
2	6	5	4	3	2	1							
3													
4	7	8	9	10	11	12							
5													
6	18	17	16	15	14	13							
7													
8	19	20	21	22	23	24							
9													
10	30	29	28	27	26	25							
11													
12	31	32	33	34	35	36							
13													

I, Randy Kolehouse, in a field survey on March 30, 19 94, do hereby certify that under requirements of P.A. 74, Michigan P.A. of 1970, the corner points mentioned in lines 1 and 2 above were in conformance with regulations and rules therefore as required in the current manual of survey instructions of the United States Department of the Interior, Bureau of Land Management or by a decree of a Court of Law and/or that the corner points mentioned in lines 3, 4 and 5 above were in conformance with the rules of the Michigan Board of Land Surveyors or by a Decree of a Court of Law; established, re-established, monumented, re-monumented, recovered, found as expressed below:

NOTE: Not more than 4 corners, all in the same town and range, may be recorded on this certificate.

A. Description of original monument and accessories and/or subsequent restoration:

K-12	1831	G.L.O. Notes	L. Lyon	Set Post	P.A. 345 1990 KENT COUNTY
	1951	Wit. Map	K.C. Surveyor	Conc. Mon. in Mon. Box	PEER APPROVED 7/28/94
	1963	Survey Records	MDSH	Mon. Box	CHAIRMAN <i>[Signature]</i>
	1972	L.C.R.C. #346	Williams & Works	Iron in Mon. Box	
	1981	L.C.R.C. #1827	Exxel Engineering	Fnd. Iron in Mon. Box/Set	K.C. Mon.
	1988	L.C.R.C. #4708	Bueche	K.C. Monument	
	1992	L.C.R.C. #6632	Bueche	K.C. Monument	

This corner was originally approved by the Kent County Remonumentation Peer Group and monumented by Exxel Engineering on 2/20/81 and was recorded per L.C.R.C. #1827.

B. Description of corner evidence found and/or method applied in restoring or reestablishing corner:

K-12 Found K.C. Monument at C/L of Clyde Park Avenue and 56th Street as reset by John Bueche (L.C.R.C. #6632) using survey records and construction plans in location as established and monument by Exxel Engineering in 1972 (L.C.R.C. #1827) where they found a 1" iron in monument box over a concrete monument which checks 1951 K.C. Surveyor's records.


L.C.R.C. #6632

"X" cut in curb N 35° W 86.98'
NE cor. conc. S 65° W 74.75'
NW cor conc. S 75° E 99.91'

The selected location is accepted by me and is generally accepted by professional surveyors as the best available evidence of the position of the original corner.

C. Description of monument for corner and accessories established to perpetuate locating the position of the corner:

K-12 Standard Kent County Monument
NE cor. conc. S 65° W 74.75'
"V" cut back curb at N end of walk N 27.52'
"X" cut in curb N 35° W 86.89'
NW cor conc. S 75° E 99.72'

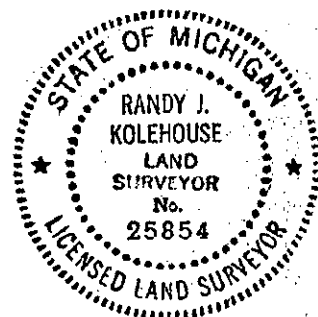

Signed by *Randy J. Kolehouse*
Surveyor's Michigan License No. 25854

Date 11/21/94