

**SURVEY & REMONUMENTATION**

APR 28 1995

Kent County Remonumentation

STATE OF MICHIGAN  
COUNTY OF KENT  
RECEIVED FOR RECORD

COMMISSION

LAND CORNER RECORDATION CERTIFICATE  
Filing Requirement of Act 74, Mich. P.A. 1970

NOV 29 AM 9:24

For corners in  
Kent

(County)

Located In:

Corner Code #/

- |                                       |                          |             |
|---------------------------------------|--------------------------|-------------|
| 1. Public Land Survey                 | T <u>6N</u> R <u>12W</u> | <u>K-13</u> |
|                                       | T _____ R _____          | _____       |
|                                       | T _____ R _____          | _____       |
|                                       | T _____ R _____          | _____       |
| 2. Property Controlling in Section    | S _____ T _____ R _____  | _____       |
|                                       | S _____ T _____ R _____  | _____       |
| 3. Miscellaneous Property in Sec.     | S _____ T _____ R _____  | _____       |
|                                       | S _____ T _____ R _____  | _____       |
| 4. Lot No. _____, Recorded Plat _____ |                          |             |
| 5. Private Claims _____               |                          |             |

*Tim J. Cole*  
REG. OF DEEDS

7493

Register of Deeds Stamp & File Number

I, Randy Kolehouse, in a field survey on March 30, 19 94, do hereby certify that under requirements of P.A. 74, Michigan P.A. of 1970, the corner points mentioned in lines 1 and 2 above were in conformance with regulations and rules therefore as required in the current manual of survey instructions of the United States Department of the Interior, Bureau of Land Management or by a decree of a Court of Law and/or that the corner points mentioned in lines 3, 4 and 5 above were in conformance with the rules of the Michigan Board of Land Surveyors or by a Decree of a Court of Law; established, re-established, monumented, re-monumented, recovered, found as expressed below:

**NOTE: Not more than 4 corners, all in the same town and range, may be recorded on this certificate.**

A. Description of original monument and accessories and/or subsequent restoration:

|      |      |                |                   |                          |
|------|------|----------------|-------------------|--------------------------|
| K-13 | 1831 | G.L.O. Notes   | L. Lyon           | Set Post                 |
|      | 1963 | Wit. Map       | K.C. Surveyor     | Leaded Stone             |
|      | 1977 | L.C.R.C. #1026 | Exxel Engineering | Leaded Stone             |
|      | 1980 | L.C.R.C. #1454 | Williams & Works  | Fnd. Stone/Set K.C. Mon. |
|      | 1988 | L.C.R.C. #4709 | Bueche            | K.C. Monument            |
|      | 1992 | L.C.R.C. #6633 | Bueche            | K.C. Monument            |

P.A. 345 1990 KENT COUNTY

PEER APPROVED 7/28/94

CHAIRMAN *Harry Hester*

This corner was originally approved by the Kent County Remonumentation Peer Group and monumented by Williams & Works on 10/27/80 and was recorded per L.C.R.C. #1454.

B. Description of corner evidence found and/or method applied in restoring or reestablishing corner:

K-13 Found K.C. Monument as reset by John Bueche on line of 60th Street running West East of East curb of Clyde Park Avenue running N-S per L.C.R.C. #6633 where he found a broken K.C. monument as set by Exxel Engineering in place of a leaded stone they found which checked K.C. Surveyor's records of L.C.R.C. #1026.


L.C.R.C. #4709  
(NW cor. Sec. 1, T5N R12W is 38.31' West)

L.C.R.C. #6633  
Nail & K.C. remon. tag in S side PP N 55° E 63.84'  
Nail & K.C. remon. tag in E side PP (4' high) S 10° E 148.38'  
SW cor. of conc. garg. to hse. N 55° W 164.59'  
SW cor. of CB header S 60° W 83.44'  
Face curb W 5.0' ±  
K.C. mon. NW 1, 5-12 West 38.31'

The selected location is accepted by me and is generally accepted by professional surveyors as the best available evidence of the position of the original corner.

C. Description of monument for corner and accessories established to perpetuate locating the position of the corner:

K-13 Standard Kent County Monument  
Nail & K.C. remon. tag in S side p. pole N 55° E 63.84'  
Nail & K.C. remon. tag in E side p. pole (4' high) S 10° E 148.38'  
SW cor. of conc. garg. to hse. N 55° W 164.59'  
SW cor. of CB header S 60° W 83.44'  
Face curb W 5.0' ±  
K.C. Mon. NW Corner 1, T5N, R12W, West 38.31"

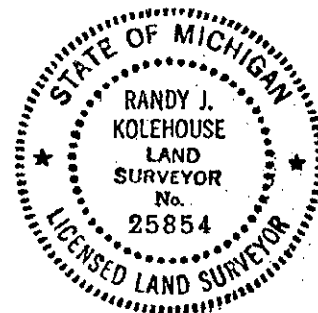

Signed by *Randy J. Kolehouse*  
Surveyor's Michigan License No. 25854

Date 11/21/94