

SURVEY & REMONUMENTATION

APR 28 1995

Kent County Remonumentation

STATE OF MICHIGAN
COUNTY OF KENT
RECEIVED FOR RECORD

COMMISSION

LAND CORNER RECORDATION CERTIFICATE
Filing Requirement of Act 74, Mich. P.A. 1970

94 NOV 29 AM 9:25

For corners in
Kent

(County)

Located In:

Corner Code-#

1. Public Land Survey	T 6N R 12W	L-5
	T R	
	T R	
	T R	
2. Property Controlling in Section	S T R	
	S T R	
3. Miscellaneous Property in Sec.	S T R	
	S T R	

T. J. Bond
REG. OF DEEDS

7496

Register of Deeds Stamp & File Number

4. Lot No. _____, Recorded Plat _____
5. Private Claims _____

	A	B	C	D	E	F	G	H	I	J	K	L	M
2	6		5		4		3		2		1		
3													
4	7		8		9		10		11		12		
5													
6	18		17		16		15		14		13		
7													
8	19		20		21		22		23		24		
9													
10	30		29		28		27		26		25		
11													
12	31		32		33		34		35		36		
13													

I, Randy Kolehouse, in a field survey on June 8, 19 94, do hereby certify that under requirements of P.A. 74, Michigan P.A. of 1970, the corner points mentioned in lines 1 and 2 above were in conformance with regulations and rules therefore as required in the current manual of survey instructions of the United States Department of the Interior, Bureau of Land Management or by a decree of a Court of Law and/or that the corner points mentioned in lines 3, 4 and 5 above were in conformance with the rules of the Michigan Board of Land Surveyors or by a Decree of a Court of Law; established, re-established, monumented, re-monumented, recovered, found as expressed below:

NOTE: Not more than 4 corners, all in the same town and range, may be recorded on this certificate.

A. Description of original monument and accessories and/or subsequent restoration:

L-5	1831	G.L.O. Notes	L Lyon	Set Post	P.A. 345 1990 KENT COUNTY
	1959	Wit. Map	K.C. Surveyor	"+" in Conc.	PEER APPROVED 11/11/94
	1959	Survey Records	MDSH	"+" in Conc.	CHAIRMAN <i>Harry Huber</i>
	1975	L.C.R.C. #907	Exxel Engineering	P.K. Nail	
	1984	L.C.R.C. #4099	Rosema	Fnd. P.K. Nail/Set K.C. Mon.	
	1988	L.C.R.C. #4711	Bueche	K.C. Mon	

The position of this corner was previously approved by the Kent County Remonumentation Peer Group monumented by Maurice J. Rosema on 9/22/84 and was recorded per L.C.R.C. #4099.

B. Description of corner evidence found and/or method applied in restoring or reestablishing corner:

L-5 Found K.C. Monument 42' ± East of C/L C&O Railroad track per L.C.R.C.'s #4099 and #4711 as set by M. Rosema in place of a P.K. he found which was set by Exxel Engineering using K.C. Surveyor and MDSH survey records. Checked L.C.R.C. #907.

L.C.R.C. #4099

L.C.R.C. #4711

Center NE'ly bolt top of E'ly conc. pier at N end N 8° W 32.23'
Center SE'ly bolt top of E'ly conc. pier at S end S 19° W 30.43'
Center NE'ly bolt top of W'ly conc. pier at N end N 52° W 79.14'
Center NE'ly bolt top of W'ly conc. pier at S end S 80° W 68.35'


Center NE'ly bolt top of E'ly conc. pier at N end N 8° W 32.23'
Center SE'ly bolt top of E'ly conc. pier at S end S 19° W 30.43'
Center NE'ly bolt top of W'ly conc. pier at N end N 52° W 79.14'
Center NE'ly bolt top of W'ly conc. pier at S end S 80° W 68.35'

The selected location is accepted by me and is generally accepted by professional surveyors as the best available evidence of the position of the original corner.

C. Description of monument for corner and accessories established to perpetuate locating the position of the corner:

L-5 Standard Kent County Monument
Center NE'ly bolt top of E'ly conc. pier at N end N 8° W 32.23'
Center SE'ly bolt top of E'ly conc. pier at S end S 19° W 30.43'
Center NE'ly bolt top of W'ly conc. pier at N end N 52° W 79.14'
Center NE'ly bolt top of W'ly conc. pier at S end S 80° W 68.35'

See L.C.R.C. #4712 for wit. to P.K. nail on viaduct

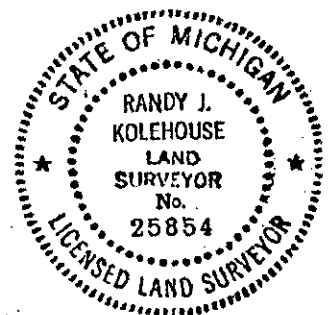

Signed by *Randy J. Kolehouse*
Surveyor's Michigan License No. 25854

Date 11/21/94